


U.S. PUBLIC LAND SURVEY MONUMENT RECORD

Note: This form is intended and designed to fulfill all requirements of Wisconsin Administrative Code, Chapter A-E 7.08 U.S. Public Land Survey Monument Record (3) (a) (b) (c) (d) (e) (f) (g) (h) (i). An additional sheet may be added if necessary to conform with said requirements.

(a) Corner location: Township 36 North
 Range 4 East/West

Town/City/Village Lynne

County Oneida

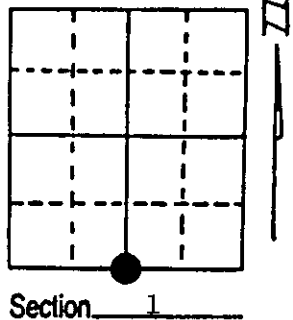


(b) (f) (g) (h) Description of monument found at this corner and if it was accepted, state all evidence (material, testimonial, occupational, plats, records, other monuments) used as a basis for accepting. If not accepted or if nothing was found, state evidence used as basis for establishing location. If reestablished through lost corner proportionate methods, indicate all monuments, distances and directions used to establish. Indicate type of monument found or set and sign post.

- May 1865 - Edward D. Palmer established this corner at 40.07 chains and set wood post for Quarter Corner with two BTs:
 7" Spruce, N23°E, 20 Links (13.20') 12" Tamarack, S13°W, 15 Links (9.90')
- 10/20/1896 - B.F. Dorr used corner to subdivide Section 1.
- 12/13/1934 - A.J. Lytle found evidence of original corner and Dorr's stake and made two new BTs:
 14" Birch, S71½°E, 20½ Links (13.53') 12" Birch, N½°W, 41 Links (27.06')
- 7/20/1994 - Milo E. Stefan found 2" x 60" iron pipe/brass cap with Dorr's stake and:
 1) Original Tamarack - a very decayed stump
 2) Lytle's Birch N½°W, 27.06' - face overgrown, in good condition
 3) Lytle's Birch S72°E, 13.5' - a decayed stump
 We made three new BTs and set plastic sign post.

(c) (d) (e) Plan view of corner with ties to at least 4 witness monuments. If in disagreement with previously established corner, show the distances between the two corners and also indicate the ties to the disputed corner.

- 1) 2" x 60" Iron Pipe/Brass Cap.
- 2) 14" Y. Birch, North, 27.08' (Lytles)
- 3) 12" Hemlock, N73°E, 40.37'.
- 4) 12" Hemlock, S55°W, 45.07'.
- 5) 5" Black Ash, N69°W, 17.00'.
- 6) Plastic Sign Post, West, 1.0'.

Distances to nail in side of BTs.
 Stump blazes scribed "BT".

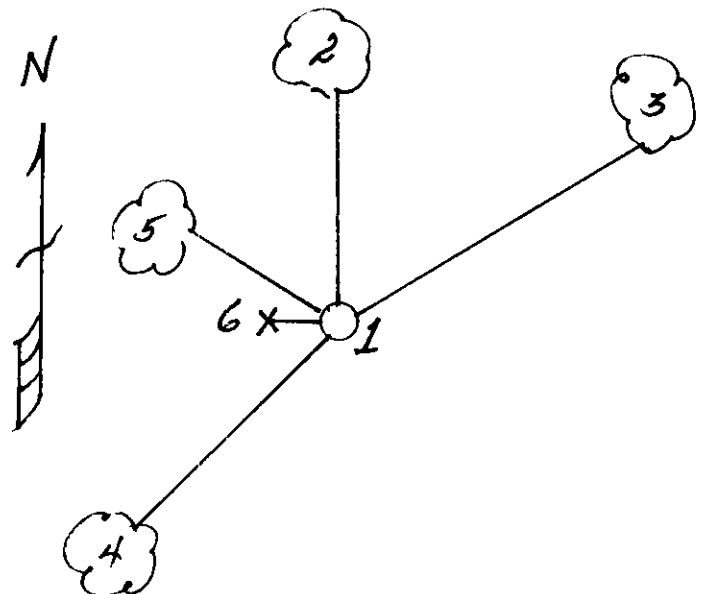

(i) I, Milo E. Stefan
 (type or print name) certify that the corner location on this record was determined by me or under my direction and control and that this U.S. Public Land Survey Monument Record is correct and complete to the best of my knowledge and belief.



Index No. E-23

Milo E. Stefan
 Signature

August 2, 1994
 Date

Stamp 3604010020