


U.S. PUBLIC LAND SURVEY MONUMENT RECORD

NOTE: This form is intended and designed to fulfill all requirements of Wisconsin Administrative Code, Chapter A-E 7.08 U.S. Public Land Survey Monument Record (3) (a-i)

A-E 7.08(3)(a) Identity of corner:
East 1/4 Corner Section 18,
Township 36 North, Range 05 East
of the Fourth Principal Meridian,
Town of Little Rice, Oneida County, Wisconsin

WISCRS - ONEIDA COUNTY
N: 153,308.821 USft (XXX,XXX.XXX)
E: 139,135.081 USft (XXX,XXX.XXX)
Datum: NAD83 (2011)
GNSS Method RTN
GNSS Control WISCRS VRS

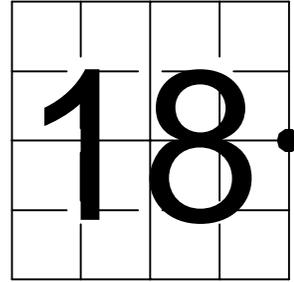

The coordinate value shown has been verified by the average of two or more GPS observations at a markedly different time. Coordinates shown in parenthesis are previously published values.

A-E 7.08(3)(b)


Original Surveyor: Joseph H. Jenkins - June 1, 1863 to June 10, 1863
Spruce 5 - S 24° W, 38 Links, Spruce 5 - N 23° E, 29 Links

THENCE:

- May 27, 1952 - Genisot Engineering - Oneida Co. Map C339 - subdivided Section 18 for William Newton Jr. - Job #1938. Map C339 does not indicate a monument or witnesses at the East 1/4 corner of Section 18, but it does indicate the NE and SE section corners, as well as a number of interior 1/16th corners and meander corners.

October 24, 2025 - I calculated a position for the East 1/4 corner based on the interior monuments and the section corners to the North and South. I made a careful search of the area surrounding the calculated position and found no evidence of the original G.L.O. monument, or of any subsequent surveys. I set a 1" diameter aluminum pipe monument, with a 2.5" diameter, Oneida County aluminum cap at the calculated position. The monument is 62" long, the top of which is flush with the surface of a Black Spruce marsh. I established 4 new reference monuments as shown below.

A-E 7.08(3)(c)(d) Plan view of corner with references to at least 4 witness monuments.

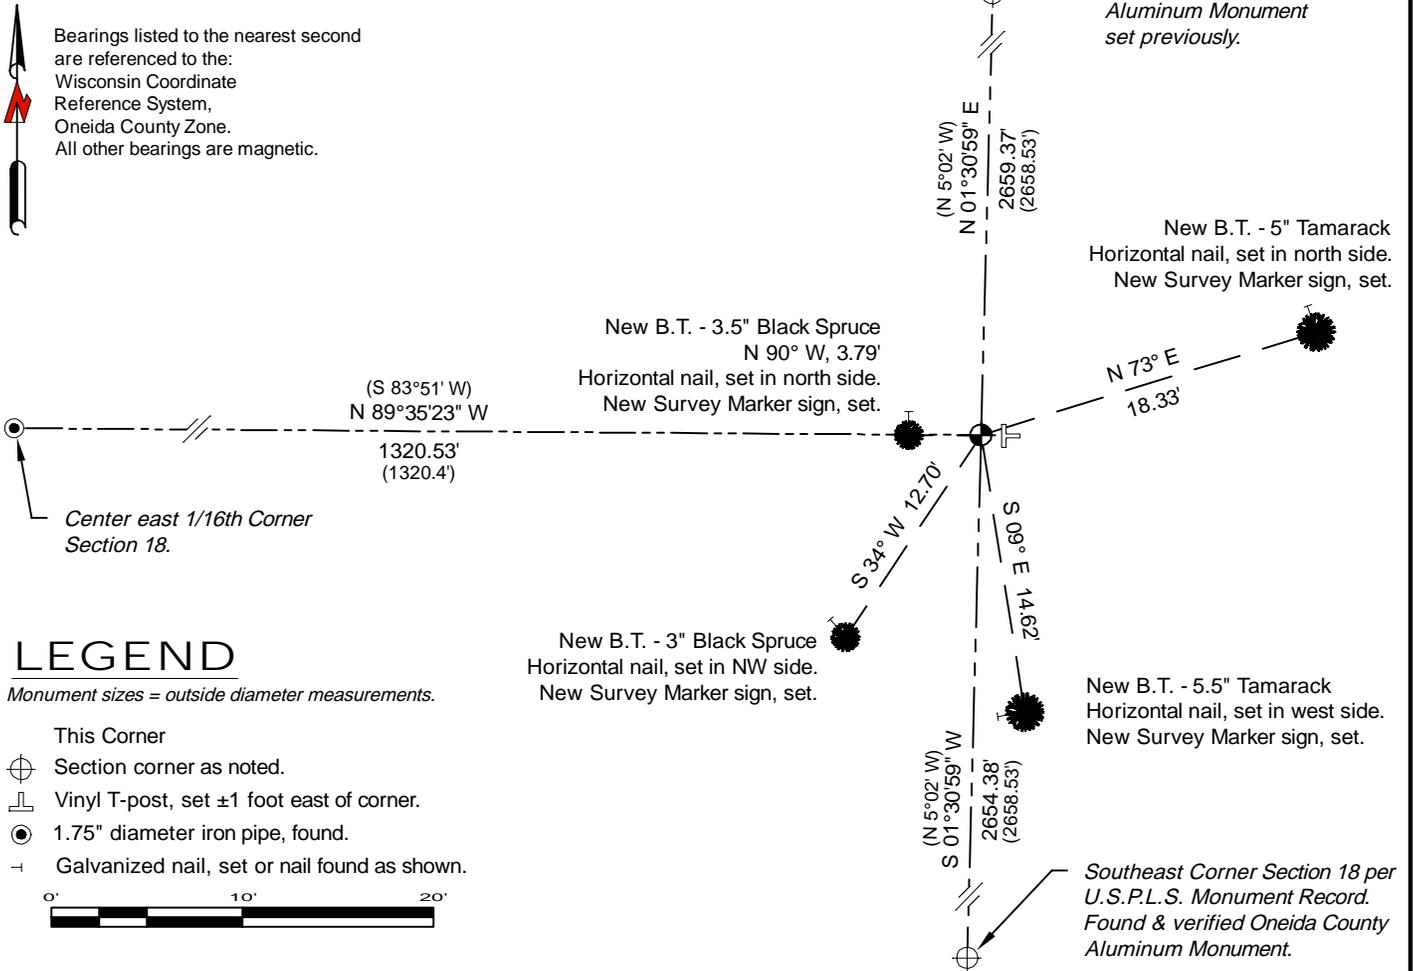

LEGEND

Monument sizes = outside diameter measurements.


- This Corner
- ⊕ Section corner as noted.
- ⊥ Vinyl T-post, set ±1 foot east of corner.
- 1.75" diameter iron pipe, found.
- ⊥ Galvanized nail, set or nail found as shown.



A-E 7.08(3)(e) 1863 Surveyor set a post, 1952 Surveyor uses the position to subdivide section. In 2025 I set an Oneida County aluminum monument from 1952 surveyors work on the interior of Section 18.

A-E 7.08(3)(f) I restored the corner through ACCEPTANCE OF AN OBLITERATED LOCATION.
A-E 7.08(3)(g)(h) This corner was not determined through lost-corner-proportionate methods.

A-E 7.08(3)(i) I, Jeffrey L. DeMuth, Professional Land Surveyor No. S-2656, hereby certify that the corner location on this record was determined by me or under my direction and control, and that this U.S. Public Land Survey Monument Record is correct and complete to the best of my knowledge, and belief.

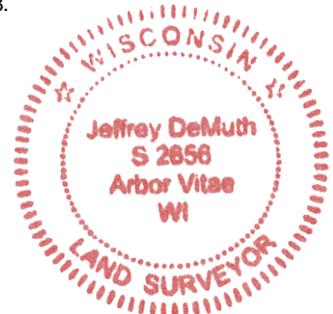

SIGNATURE

October 27, 2025

DATE