

CERTIFIED LAND CORNER RESTORATION

History of original corner establishment:
 The original Government Survey was performed by Alfred Millard, Deputy Surveyor
 in 1860

Wood Post Set	12"	S 5° E	22 links
Yellow Pine	12"	N 27° W	10 links
Spruce Pine	12"		


Description of corner evidence found:
 7" X 7" Granite monument and post

State of Wisconsin }
 County of Lincoln } ss.
 John H. Fisher }
 I, do hereby
 certify that on the 9 day
 of September, 1983, I found
 evidence of the North One Quarter
 corner of Section 1
 Township 35 North, Range
 5 East, Fourth, Principal Meridian,
 as described hereon; and that from this evidence
 I established a new monument and accessories
 as described hereon to perpetuate the original
 location of this corner.

Resident witnesses:
 None

Description of monument and accessories I established to perpetuate the original location of this corner.

Corner in good condition, I established new witnesses.
 2" Aluminium pipe with aluminium tablet, N44°W, 0.70 feet
 stamped T36N, R5E, witness corner, 1/4, S36, S 1, T35N, S-836, 1983, S44°E
 Nail in Jack Pine 12" N54°E 9.62 feet
 Nail in Jack Pine 9" N83°W 36.10 feet
 Nail in Jack Pine 12" S25°W 18.00 feet
 Nail in Jack Pine 9" S 6°E 14.63 feet

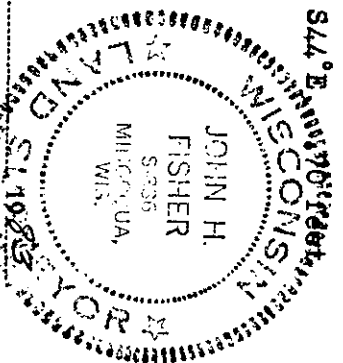


Dated at Minocqua, Wis., this 27th day of October, 1983
 Signature: *John H. Fisher* Title Registered Land Surveyor Registration No. S-836
 (County Surveyor, Registered Land Surveyor, or other duly authorized official)

Office of Register of Deeds, County of Lincoln, I hereby certify that the within
 instrument was filed in this office for record on the _____ day of _____, 19____
 at _____ o'clock _____ M.

(Register of Deeds)

By _____ Deputy

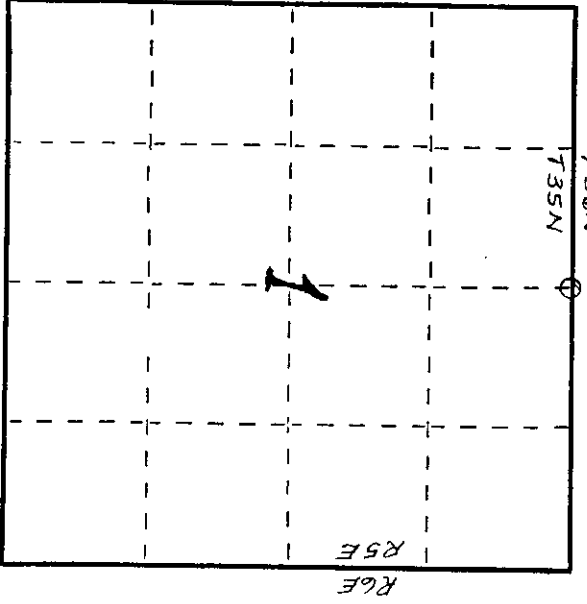

○ = Corner monument restored.

07009235022