U.S. PUBLIC LAND SURVEY MONUMENT RECORD

Note: This form is intended and designed to fulfill all requirements of Wisconsin Administrative Code, Chapter A-E 7.08 U.S. Public Land Survey Monument Record (3) (a) (b) (c) (d) (e) (f) (g) (h) (i). An additional sheet may be added if necessary to conform with said requirements.

(a) Corner location: Township 36 North

Range 6 East/[redacted]

Town/[redacted] of Nokomis

County of Oneida

REGISTER OF DEEDS OFFICE
ONEIDA COUNTY, WIS
FILED
MAY 23 1991
At ____ O'Clock ____ M
THOMAS H. LEIGHTON
REGISTER OF DEEDS

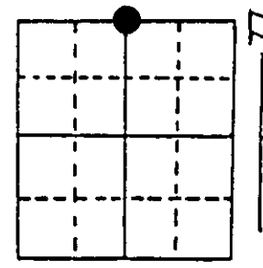

Section 15

(b) (f) (g) (h) Description of monument found at this corner and if it was accepted, state all evidence (material, testimonial, occupational, plats, records, other monuments) used as a basis for accepting. If not accepted or if nothing was found, state evidence used as basis for establishing location. If reestablished through lost corner proportionate methods, indicate all monuments, distances and directions used to establish. Indicate type of monument found or set and sign post.

Oct. 1862, Orig. cor. estab. by Joseph H. Jenkins West corrected between 10 & 15..... 40.00 set ¼ post, B.T.s Blk Pine 8 N 54 E 8 & Blk Pine 8 S 62 E 39.

1901 D.H. Vaughan found stumps of org trees, set post and made new bearing Y. Pine 13 S 86 W 29 links.

1991 I found a 1" iron pipe for cor. with 4" sq. wood post on the north side of the cor. I set a 2" x 30" Oneida County Capped Monument to replace the iron pipe for the cor. and made witnesses as shown below.

(c) (d) (e) Plan view of corner with ties to at least 4 witness monuments. If in disagreement with previously established corner, show the distances between the two corners and also indicate the ties to the disputed corner.

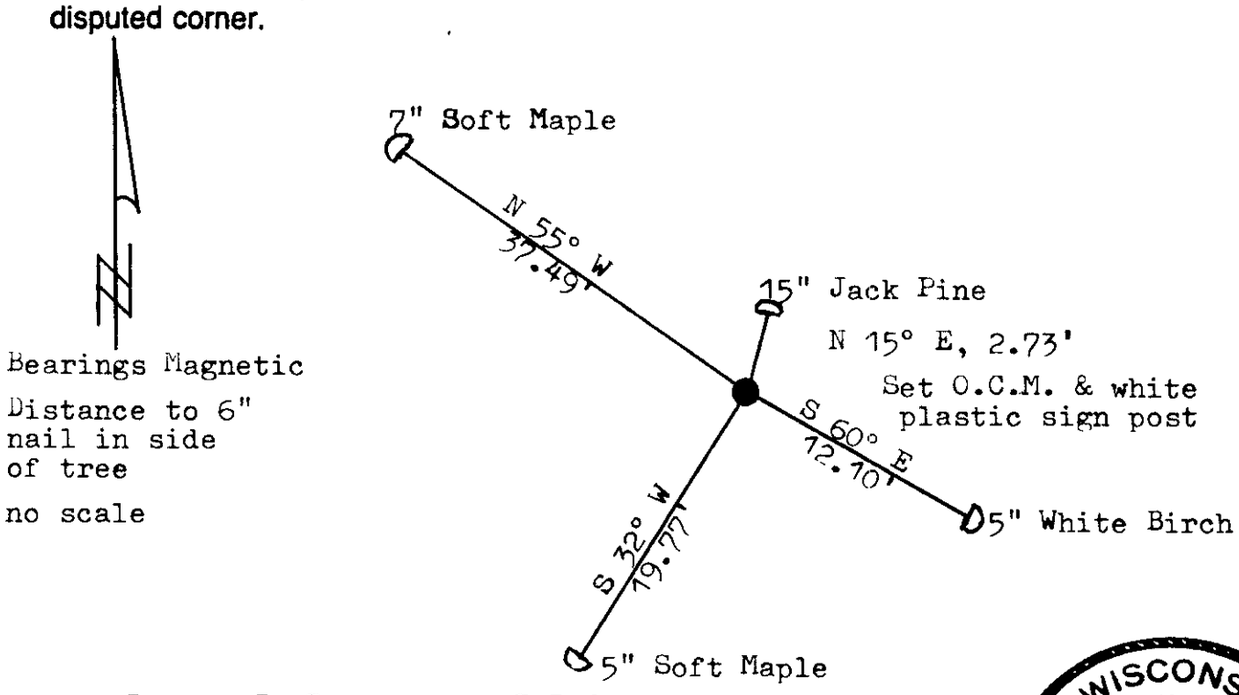

(i) I, Lester J. Schmit R.L.S. 1192 (type or print name) certify that the corner location on this record was determined by me or under my direction and control and that this U.S. Public Land Survey Monument Record is correct and complete to the best of my knowledge and belief.

Lester J. Schmit — 7 May 91

Signature — Date

WISCONSIN LESTER J. SCHMIT S-1192 EDMONTON, WIS. LAND SURVEYOR

Stamp 3606100020

Index No. J-15