

U.S. PUBLIC LAND SURVEY MONUMENT LOCATION RECORD

Recorders Data

CORNER: NW Section SECTION: 13 TOWNSHIP 36 NORTH RANGE 6 EAST/WEST

FOR M.C. CORNER INDICATE: NAME OF WATERWAY N/A SECTION LINE N/A

(CITY)(VILLAGE)(TOWN) OF: Nokomis COUNTY OF: Oneida

Description of monument found or placed and all other evidence used as a basis for monument location; including all monuments and related measurements required if the corner location is reestablished by lost corner proportionate methods. Also indicate name of original surveyor, survey date, corner monument set and established bearing trees, witness or reference monuments with ties from available records.

An old 2" dia. iron pipe monument found loose and bent about 45° 16" below top end in the center cavity of a cairn of large rocks at this corner location; I carefully removed the bent iron pipe, which also had a rusting 1" dia. steel tube in its top, and was 40" long, and reset the corner location with a standard 2" dia. by 30" long aluminum pipe monument with a stamped Oneida County cap about 3" above crown of the rock cairn. The corner falls about 8' South of an old unimproved East/West woods roadway and about 118' East of its juncture with an old woods road South. I left the old iron pipe flat on grade nearby.

In 1862, Jenkins/HLO set a wood post as the section corner and marked OMTs, a 7" Pj N19°W 111 lks, now gone, a 2" Py N58°E 97 lks, now a probable nearly obliterated root crown, a 3" Pj S64°E 17 lks, now gone, and a 5" Py S57°W 168 lks, now indeterminate for locational purposes. In 1978, Wis DOT noted a 2" I.P. at corner per Oneida Co. Plat of Survey A-410.


A 1987 map by W. South of a 1957 Owen-Illinois survey of the East 1/2 of adjoining Section 14, indicates an undescribed monument at this corner "by others", with no ties noted.

This corner recovery was completed June 25, 1998 and was directly witnessed by a longtime local resident/owner Phillip White, age 62, who stated he knew this corner location since he was a young man in the area.

No other corner evidence observed or detected within corner location area.

Plan view map of monument location with bearing and distance ties to a minimum of four(4) described witness or reference monuments of concrete, natural stone, iron, live bearing trees or equivalent material. If applicable, also show a minimum of two(2) bearing and distance ties to any other monument found and not accepted; including the bearing and distance from the accepted monument. Indicate the basis for bearings of reference ties if not referenced to magnetic north.

NORTH

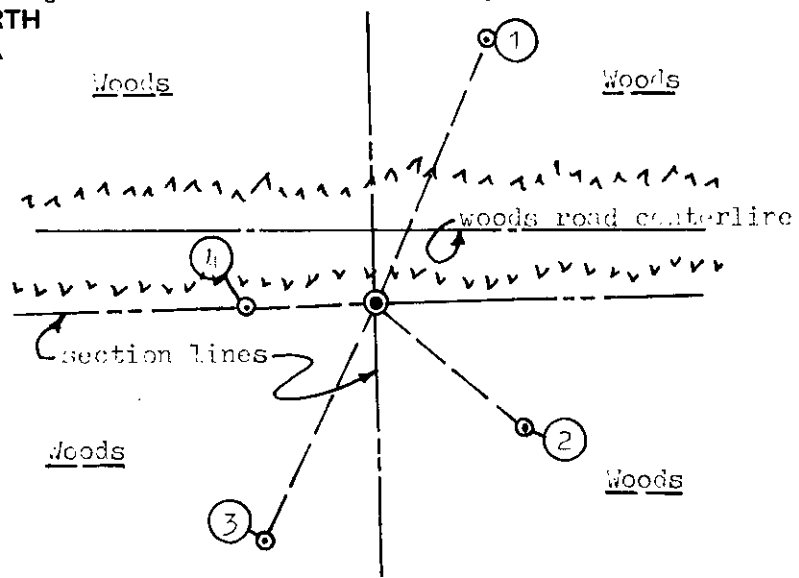

WITNESS MONUMENT TIES:

- ① New BT South 10" Nr of a clump of four, N23°E 30.14'.
- ② New BT 16" Or S49°E 20.43'.
- ③ New BT 6" Or S26°W 27.55'.
- ④ New BT 6" Aspen West 13.86'.

Note: Standard white poly 'T' marker post set 20" North of corner monument. Obvious previous survey traverse flagging observed along East/West roadway West of corner and upon a stick in old iron pipe found.


SCALE: 1" = 20'

Unless otherwise indicated, all bearing tree ties are to a .25" dia. by 2.5" long PK nail with a 1.25" dia. steel washer driven into unblazed right face and a .25" dia. by 2.5" long PK nail with a 2" dia. steel washer stamped 'BT' is also driven into unblazed face of bearing tree at DBH; the basis for measured bearings is magnetic to nearest degree and all tie distances are horizontal measure to nearest 1/100th feet.

LAND SURVEYOR CERTIFICATION:

I, William C. Rohde, hereby certify that I am a duly licensed Professional Land Surveyor in Wisconsin, that this USPLS monument location was determined by me or under my direction and control, and that this U.S. Public Land Survey Monument Location Record is true and correct to the best of my knowledge and belief.

William C. Rohde Date: 7-13-98
Signature

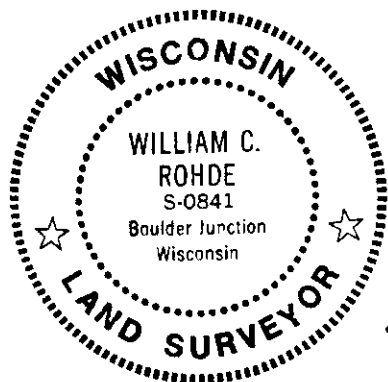

RLS SEAL

SHEET NO. 1 OF 1

This form is intended to fulfill requirements of Chapter A-E 7.08 (3)(a)(b)(c)(d)(e)(f)(g)(h)(i) U.S. Public Land Survey Monument Location Record, Wisconsin Administrative Code. Use reverse side for geodetic location data and/or continuation purposes.

	13		

INDEX NO.

SECTION LOCATION MAP

INDEX NO. J 21
3606110000