


U.S. PUBLIC LAND SURVEY MONUMENT RECORD

Note: This form is intended and designed to fulfill all requirements of Wisconsin Administrative Code, Chapter A-E 7.08 U.S. Public Land Survey Monument Record (3) (a) (b) (c) (d) (e) (f) (g) (h) (i). An additional sheet may be added if necessary to conform with said requirements.

(a) Corner location: Township 36 North
 Range 7 East/West
 Town/City/Village Woodboro
 County Oneida

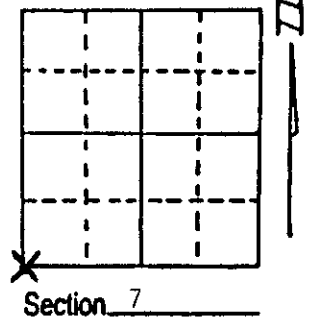

(b) (f) (g) (h) Description of monument found at this corner and if it was accepted, state all evidence (material, testimonial, occupational, plats, records, other monuments) used as a basis for accepting. If not accepted or if nothing was found, state evidence used as basis for establishing location. If reestablished through lost corner proportionate methods, indicate all monuments, distances and directions used to establish. Indicate type of monument found or set and sign post.

8/31/1860 - Alfred Millard set wood post at 80.00 chains:
 22" White Pine, N49°E, 47 links 20" White Pine, S31°E, 71 links
 20" White Pine, S10°W, 31 links 24" White Pine, N47°W, 54 links

10/4/1937 - V. Maine found remains of stake and stumps of original BTs. Set a county monument with a 28" white pine stump, N62°W, 58½ links (38.61').


2/15/1989 - Milo E. Stefan found county monument in good condition with large white pine stump N62°W, 38.6'.

(c) (d) (e) Plan view of corner with ties to at least 4 witness monuments. If in disagreement with previously established corner, show the distances between the two corners and also indicate the ties to the disputed corner.

1. 2" x 60" iron pipe/brass cap.
2. 8" Sugar Maple, N78°E, 28.15'
3. 3" Sugar Maple, S63°E, 24.60'
4. 6" Sugar Maple, S18°W, 6.45'
5. 10" Red Oak, North, 15.57'
6. Plastic sign post, NW, 1.2'

Distances measured to nail in side of trees.

Trees scribed "BT" in stump blaze.

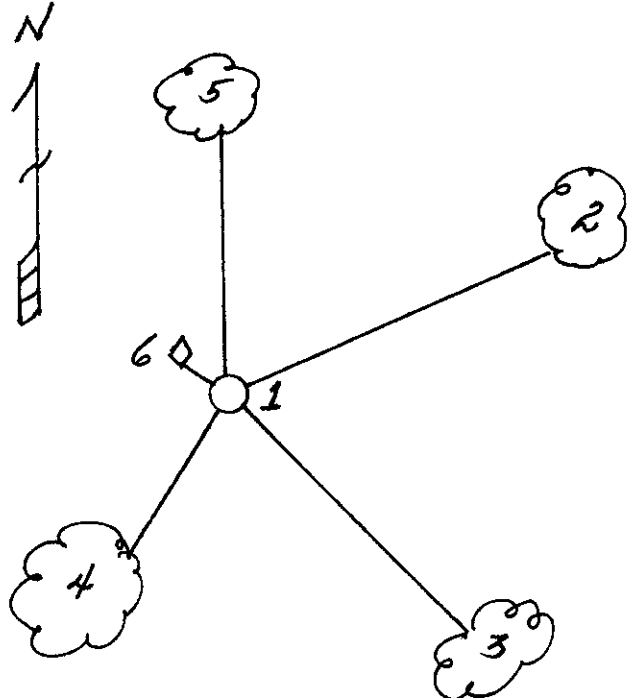

(i) I, Milo E. Stefan
 (type or print name) certify that the corner location on this record was determined by me or under my direction and control and that this U.S. Public Land Survey Monument Record is correct and complete to the best of my knowledge and belief.

Milo E. Stefan
 Signature

2/16/89
 Date



Index No. J-1

3606120000