

# U.S. PUBLIC LAND SURVEY MONUMENT RECORD

Note: This form is intended and designed to fulfill all requirements of Wisconsin Administrative Code, Chapter A-E 7.08 U.S. Public Land Survey Monument Record (3) (a) (b) (c) (d) (e) (f) (g) (h) (i). An additional sheet may be added if necessary to conform with said requirements.

(a) Corner location: Township 36 North

Range 6 East

Town                      of Nokomis


County                      of Oneida

REGISTER OF DEEDS OFFICE  
ONEIDA COUNTY, WIS.

FILED

MAY 23 1991

At                      O'Clock                      M  
**THOMAS H. LEIGHTON**  
REGISTER OF DEEDS

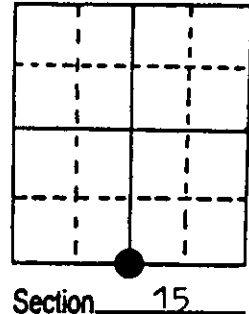

(b) (f) (g) (h) Description of monument found at this corner and if it was accepted, state all evidence (material, testimonial, occupational, plats, records, other monuments) used as a basis for accepting. If not accepted or if nothing was found, state evidence used as basis for establishing location. If reestablished through lost corner proportionate methods, indicate all monuments, distances and directions used to establish. Indicate type of monument found or set and sign post.

Oct. 1862, Orig. cor. estab. by Joseph H. Jenkins West corrected between 15 & 22.... 39.60 set 1/4 section post, B.T.s Blk Pine 8 S 88 W 33 & Blk Pine 8 N 65 W 34.

1906 D.H.Vaughan found cor. with new Y. Pine stump 15 S 14 1/2 W 104, no others near.


1978 I found a 1 1/4" iron pipe for the corner with farm fields in all directions

1991 The 1 1/4" iron pipe has been removed by the owner of the lands. From my survey of 1978, I relocated the corner position, set a 2" x 30" Oneida County Capped Monument and made witnesses as shown below.

(c) (d) (e) Plan view of corner with ties to at least 4 witness monuments. If in disagreement with previously established corner, show the distances between the two corners and also indicate the ties to the disputed corner.



All witnesses are 3/4" iron pipe

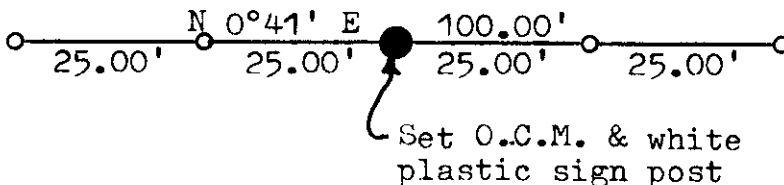

Bearings Magnetic  
Distance to 6"  
nail in side  
of tree  
No scale

(i) I, Lester J. Schmit R.L.S. 1192  
(type or print name) certify that the corner location on this record was determined by me or under my direction and control and that this U.S. Public Land Survey Monument Record is correct and complete to the best of my knowledge and belief.

Lester J. Schmit 13 May 91  
Signature Date



Stamp  
3608150020

Index No. N-15