

CERTIFIED LAND CORNER RESTORATION

Index No. MA - 2



State of Wisconsin

County of Oneida } ss.

History of original corner establishment:
 Corner position falls 2.0' north of corner of fence line
 Runs north and west

I Glen Barker, do hereby
 certify that on the 9th day
 of February, 1984, I ~~Restored~~ Estab.
~~evidence of the~~ SW 1/16
 corner of Section 18
 Township 36, North, Range
6 East, Fourth Principal Meridian,
 as described hereon; and that from this evidence
 I established a new monument and accessories
 as described hereon to perpetuate the original
 location of this corner.

Resident witnesses:
J. Claflin - RL
H. Wagoner

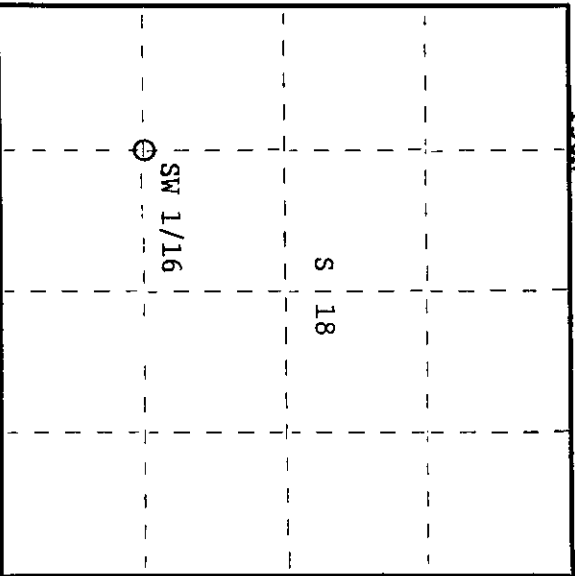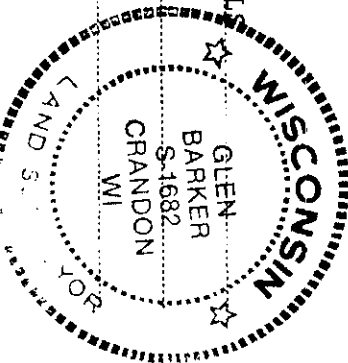

○ = Corner monument restored.

CERTIFIED LAND CORNER RESTORATION

History of original corner establishment:

Corner position falls 2.0' north of corner of fence line
 Runs north and west

Description of corner evidence found:

Corner established by subdivision of the SW 1/4 Section 18.
 SW 1/16 sets 1323.11' of ~~WC~~ WC 1/16 and 1307.23' of SC 1/16

Description of monument and accessories I established to perpetuate the original location of this corner.
 Set a 1" iron pipe with 2" diameter alloy cap stamped:
 Monument projects 18" above ground

Marked NBTs:

- Jack pine 10" N17E 8.93' SW 1/16 S 18 T36N R6E
- Red pine 6" S70E 12.90' SW 1/16 S 18 T36N R6E
- Scribed 1/16 - B.T. CPI - 1984

Dated at Rhinelander, Wis., this 20th day of February, 1984

Signature Glen Barker Title Surveyor Registered Land Surveyor Registration No. S1682
 (County Surveyor, Registered Land Surveyor, or other duly authorized official)

Office of Register of Deeds, County of Oneida, I hereby certify that the within
 instrument was filed in this office for record on the 23rd day of May, 1984
 at 11:00 o'clock A. M.

Doris Savage Tucker
 (Register of Deeds)

By: _____ Deputy

3606181030