

CERTIFIED LAND CORNER RESTORATION

Index No. 0 - 5

State of Wisconsin

County of Oneida } ss.

I Glen Barker do hereby certify that on the 2nd day of December 19 83, I found Estab. ~~the~~ the S 1/16 corner of Sections 29 & 30 Township 36 North, Range 6 East, Fourth Principal Meridian,

as described hereon; and that from this evidence I established a new monument and accessories as described hereon to perpetuate the original location of this corner.

History of original corner establishment:

Someone's 2 1/2" iron pipe sets on east edge of side of Lund Road, bears N86E 19.70' of new position.

Description of corner evidence found:


Total distance from section corner 29-30-31-32 to 1/4 corner between 29 & 30 is 2661.38' Set S 1/16 1330.69' intermediate.

Resident witnesses:

J. Clafin - RLS

H. Wagoner

T36N

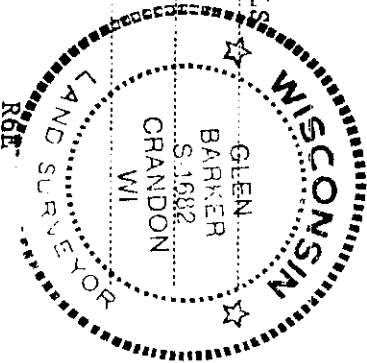


Description of monument and accessories I established to perpetuate the original location of this corner.

Set a 1"x24" iron pipe in Lund Road for S 1/16 6" below surface.

Set a 1" (O.D.) with 2" diameter alloy cap 33.0' west of true corner for reference monument. Cap stamped:

Marked NBT to true corner: Jack pine 5" N35W 33.75' B.O. - 1 1/2" iron pipe N88E 22.07' S 1/16 30 29 REF. Cor.

E. 33 Ft. CPI - 1983

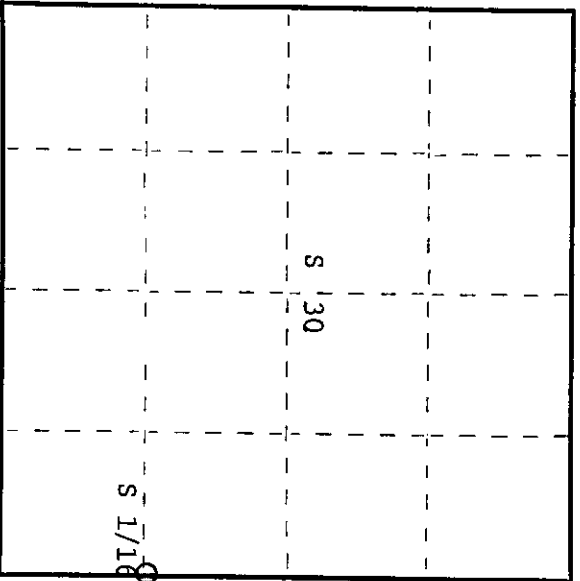

O = Corner monument restored.

Dated at Rhinelander, Wis., this 13th day of February, 1984.

Signature: Glen Barker Title: Registered Land Surveyor Registration No. S1682 (County Surveyor, Registered Land Surveyor, or other duly authorized official)

Office of Register of Deeds, County of Oneida, I hereby certify that the within instrument was filed in this office for record on the 23rd day of May, 1984 at 11:00 o'clock a.m.

Dee Lange Kuehn (Register of Deeds)

By: Deputy

3606301000