

State of Wisconsin } ss.
 County of Oneida


CERTIFIED LAND CORNER RESTORATION
 History of original corner establishment:
 No evidence of any previous corner.

I, Glen Barker, do hereby
 certify that on the 5th day
 of December, 1983, before me
~~and before~~ the SC 1/16
 corner of Section 30
 Township 36 North, Range
 6 East, Fourth Principal Meridian,


as described hereon; and that from this evidence
 I established a new monument and accessories
 as described hereon to perpetuate the original
 location of this corner.

Resident witnesses:

J. Clafin - RLS
 H. Wagoner

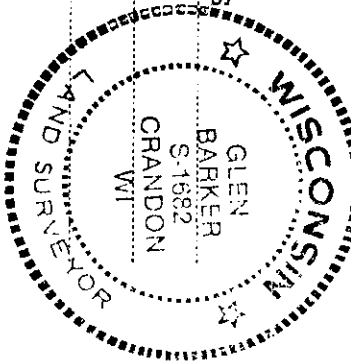

T36N R6E

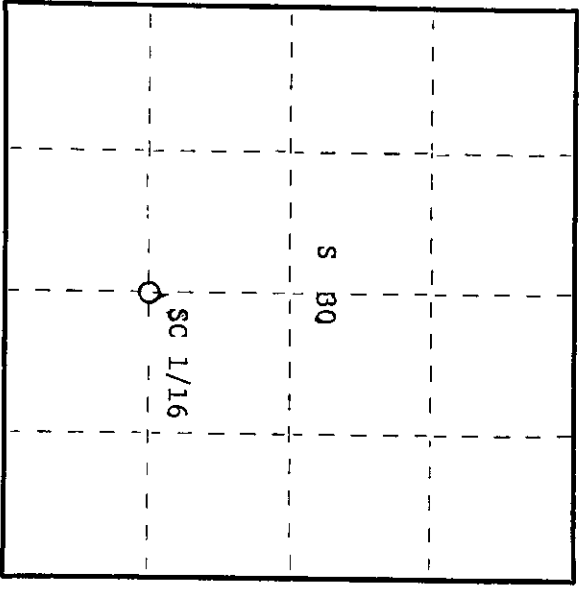

○ = Corner monument restored.

Description of corner evidence found:

Total distance from 1/4 corner between Sections 30 & 31 to C 1/4 Section 30 is 2648.02'.
 Set SC 1/16 1324.01' intermediate.

Description of monument and accessories I established to perpetuate the original location of this corner.
 SET a 1" (O.D.) iron pipe with 2" diameter alloy cap stamped:

Monument projects 18" above ground.			
Marked NBTs			
Red pine 10"	N27W	11.79'	SC 1/16 S 30
Red pine 5"	N88W	11.72'	
Scribed 1/16 - B.T.			CPI - 1983

Dated at Rhinelander, Wis., this 13th day of February, 1984

Signature: *Glen Barker* Title: Registered Land Surveyor Registration No. 51682
 (County Surveyor, Registered Land Surveyor, or other duly authorized official)

Office of Register of Deeds, County of Oneida
 Instrument was filed in this office for record on the 23rd day of May, 1984
 at 1:00 o'clock P.M.

Doris George Kuehn
 (Register of Deeds)

By: Deputy

Index No. U-3

2010200630