

CERTIFIED LAND CORNER RESTORATION

Index No. T-3

State of Wisconsin }
 County of Oneida } ss.

I Glen Barker do hereby certify that on the 5th day of December 19 83, I ~~found~~ Estab. ~~the~~ C 1/4 corner of Section 30 Township 36 North, Range 6 East, Fourth Principal Meridian, as described hereon; and that from this evidence I established a new monument and accessories as described hereon to perpetuate the original location of this corner.

History of original corner establishment:
 No evidence of any previous corner.

Description of corner evidence found:


Established C 1/4 by subdivision of section 30.
 C 1/4 sets 2644.52' of N 1/4
 2638.89' of E 1/4
 2648.02' of S 1/4
 and 2415.42' of W 1/4

Description of monument and accessories I established to perpetuate the original location of this corner.
 Set a 2 1/2" aluminum pipe with alloy cap stamped:
 T36N R6E
 C 1/4 S 30

Monument projects 18" above ground.


Marked NBTs:

| | | | |
|----------------------|------|--------|--------------|
| Cedar 7" | N54W | 32.17' | S1682 - 1983 |
| Cedar 10" | N60W | 39.02' | |
| Cedar 12" | S29W | 43.42' | |
| Scribed C 1/4 - B.T. | | | |

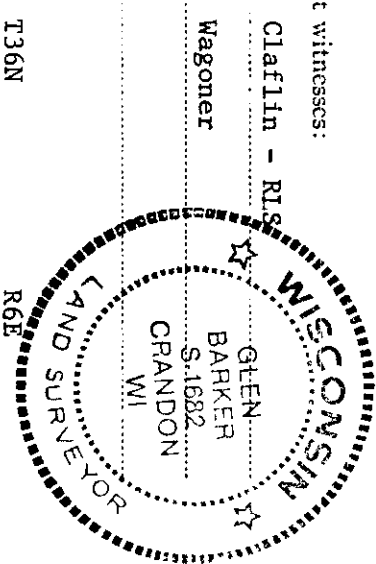

Resident witnesses:

J. Clafin - RIS
 H. Wagoner

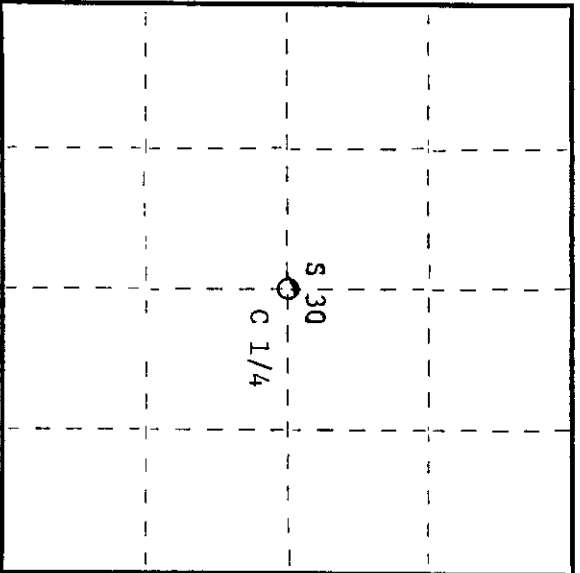

O = Corner monument restored.

Dated at Rhinelander, Wis., this 13th day of February, 19 84

Signature *Glen Barker* Title *Surveyor* Registered Land Surveyor Registration No. S1682
 (County Surveyor, Registered Land Surveyor, or other duly authorized official)

Office of Register of Deeds, County of Oneida
 Instrument was filed in this office for record on the 29th day of May, 19 84
 at 11:00 o'clock a.m.

Debra Leauge Kuehn
 (Register of Deeds)

By Deputy

3606302020