

CERTIFIED LAND CORNER RESTORATION

State of Wisconsin } ss.
County of Lincoln

I Lester J. Schmit do hereby certify that on the 31st day of December, 19 75, I found evidence of the Northeast corner of Section 3 Township 35, North, Range 6 East, Fourth, Principal Meridian, as described hereon; and that from this evidence I established a new monument and accessories as described hereon to perpetuate the original location of this corner.
Resident witnesses:

History of original corner establishment:
Surveyor: Alfred Willard
Date: 31 August 1860
Monumentation: Wood Post
Witnesses: Yellow Pine 16; N 10° E; 98 links
Yellow Pine 16; S 40° E; 65 links
No others near.

Description of corner evidence found:
2" x 30" Iron Pipe, 1" above surface of ground and 11.6' West of centerline of railroad tracks.
Witnesses: 16" Oak; N 46° W; 47.70'
19" Norway Pine; S 39° W; 92.70'

Description of monument and accessories I established to perpetuate the original location of this corner.

Berritsen Monument - 30" (Set 1" above surface of ground)
Placed 2" x 30" Iron Pipe adjacent to Berritsen Monument, with top of said Iron Pipe 9" below surface of ground. Berritsen Monument is Northeast corner of Section 3.

Witnesses: P.K. Nail in 5" Oak; N 70° E; 37.04'
P.K. Nail in 15" Jack Pine; S 15° E; 153.28'


Dated at Rhineland, Wis., this 5th day of February, 19 76

Signature Lester J. Schmit Title Land Surveyor Registration No. S-1192
(County Surveyor, Registered Land Surveyor, or other duly authorized official)

Office of Register of Deeds, County of _____, I hereby certify that the within instrument was filed in this office for record on the _____ day of _____, 19 _____ at _____ o'clock _____ M.

(Register of Deeds)

By _____ Deputy

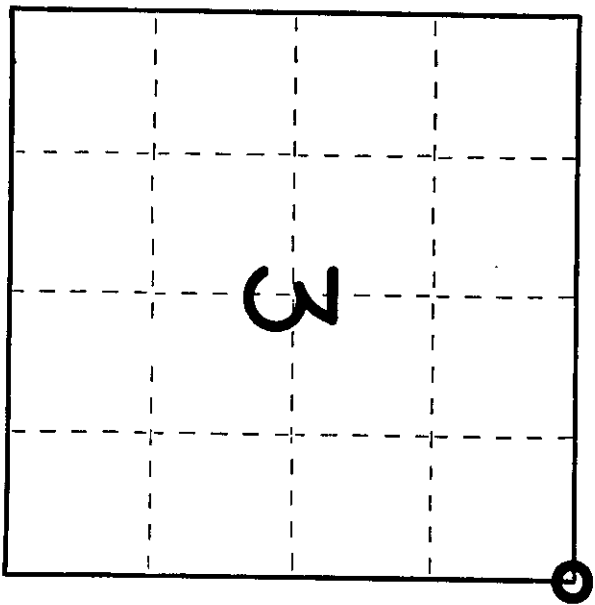

○ = Corner monument restored.

Index No. Z-17
SE Cor. 34 - 36 - 6
From Lincoln City Files

3606340000