

U.S. PUBLIC LAND SURVEY MONUMENT RECORD


Note: This form is intended and designed to fulfill all requirements of Wisconsin Administrative Code, Chapter A-E 7.08 U.S. Public Land Survey Monument Record (3) (a) (b) (c) (d) (e) (f) (g) (h) (i). An additional sheet may be added if necessary to conform with said requirements.

(a) Corner location: Township 36 North

Range 7 East/West

Town/City/Village Woodboro

County Oneida

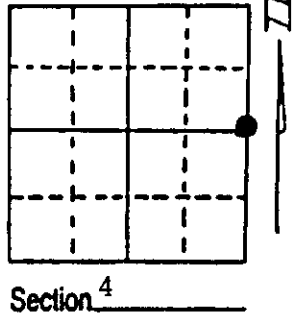


(b) (f) (g) (h) Description of monument found at this corner and if it was accepted, state all evidence (material, testimonial, occupational, plats, records, other monuments) used as a basis for accepting. If not accepted or if nothing was found, state evidence used as basis for establishing location. If reestablished through lost corner proportionate methods, indicate all monuments, distances and directions used to establish. Indicate type of monument found or set and sign post.

1862-Joseph H. Jenkins set $\frac{1}{4}$ post and made the following B.T.'s:
 Fir 7" S 54° W 20 links, W. Pine 14" S 60° E 25 links.
 1893-Dorr finds $\frac{1}{4}$ post at 49.82 chains from SE corner.
 1912-Vaughan set $\frac{1}{4}$ post at 39.04 chains and made the following B.T.'s:
 W. Pine stump 10" N 53° E 35 links, W. Pine stump 20" S 2° W 32 $\frac{1}{2}$ links.
 1933-H.C. Hall's notes state that in 1912 D.H. Vaughan did some work in the SE $\frac{1}{4}$ Section 4 but ignored the original E $\frac{1}{4}$ corner used by Dorr. Hall states that Vaughan did some work in Section 3 identifying several of Dorr's interior corners and using some to relocate the $\frac{1}{4}$ corner between Sections 3 & 4 and ignoring his own survey of 1912!
 1958- Sy M. Poskie shows E $\frac{1}{4}$ corner of Section 4 3288.00' North of SE corner Section 4.
 1995-William E. Bandow set O.C.M. for E $\frac{1}{4}$ corner Section 4 and witnessed as shown below.

(c) (d) (e) Plan view of corner with ties to at least 4 witness monuments. If in disagreement with previously established corner, show the distances between the two corners and also indicate the ties to the disputed corner.

NOTE: BEARINGS TAKEN WITH HANDHELD MAGNETIC COMPASS. SET WHITE POST 6' WEST OF CORNER.

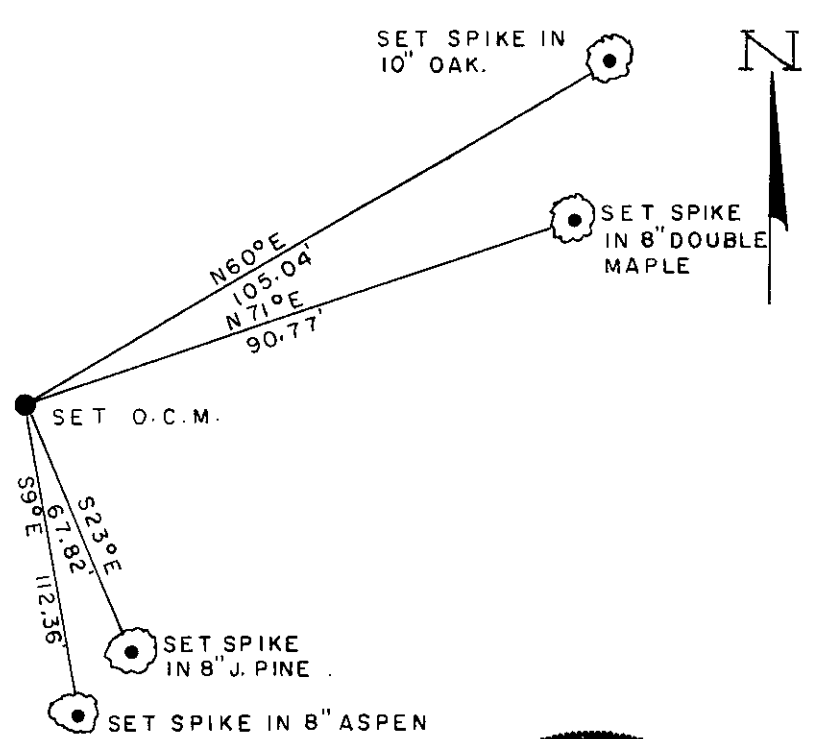

NOTE: SEE REVERSE SIDE FOR SKETCH

(i) I, William E. Bandow
 (type or print name) certify that the corner location on this record was determined by me or under my direction and control and that this U.S. Public Land Survey Monument Record is correct and complete to the best of my knowledge and belief.

William E. Bandow 12-12-95
 Signature Date



Stamp
 3607042000

Index No. C-13

REGISTER OF DEEDS OFFICE
ONEIDA COUNTY, WIS.

FILED
DEC 12 1995

At _____ O'Clock _____ M
THOMAS H. LEIGHTON
REGISTER OF DEEDS

NOTE: NO SCALE

