

CERTIFIED LAND CORNER RESTORATION

State of Wisconsin }
County of Oneida } ss.



I Jean F. Resvick, do hereby certify that on the 27 day of January, 1982, I found evidence of the South Quarter corner of Section 5 Township 36 North, Range 7 East, Fourth Principal Meridian, as described hereon; and that from this evidence I established a new monument and accessories as described hereon to perpetuate the original location of this corner:

Description of original monument and accessories and subsequent restorations:
Surveyed in 1862 by Joseph H. Jenkins
Set 1/4 post, Spruce 6", S67E, 40 lks. Spruce 6", N20W, 20 lks.
4 chains East leave swamp, bears N & S.
3 chains West leave swamp, bears NW & SE.
Survey by Wincentzen, dated Oct. 30, 1959
Set Iron Pipe and made new bearing trees. W. Pine 20", S23W, 33.5 feet
W. Pine 10" S 2W, 36.6 feet
Survey by Lester Schmit in 1975. Found iron pipe and W. Pine 23", S25W, 33.5 feet, W. Pine 12", S7W, 36.4 feet.

Description of corner evidence found:
Iron Pipe
Spruce stump remains S67E, 40 lks.
Spruce stump remains N20W, 20 lks.
Leave swamp East, 4 chains N - S.
Leave swamp West, 3 chains, NW-SE.
White Pine 23", S23W, 33.5 feet
White Pine 12", S 7W, 36.4 feet

Description of monument and accessories I established to perpetuate the location of this corner:
I replaced iron pipe with a 2" diameter, aluminum pipe, 6 foot long, with driving point, and capped with an Oneida county aluminum cap stamped to identify corner.
No new trees were available.

*Corner data checked with record, field inspected & accepted as correct. Robert H. Winat
Oneida County Surveyor*

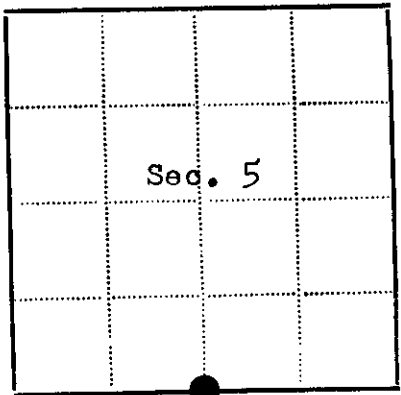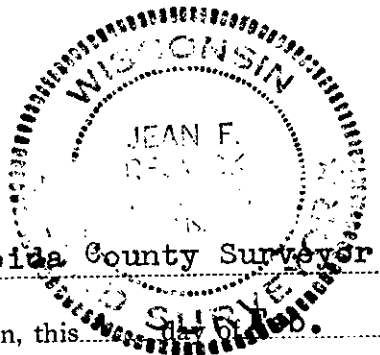

Resident witnesses Robert Winat, Oneida County Surveyor

Dated at Rhineland Wisconsin, this 27 day of January, 1982

Signature Jean F. Resvick Title Land Surveyor
(County Surveyor, Registered Land Surveyor, or other duly authorized official)

Surveyors Registration No. S- 802

Office of Register of Deeds County of Oneida

I hereby certify that the within instrument was filed in this office for record on the 25th day of August, 1982, and was filed in Book No. _____ Page No. _____ of County Records.

Signature Loris Verage Kuehn Title Register of Deeds

Township 36 North, Range 7 East, Section 5, Index No. E-7, Page No. _____

3607050020

E-7