

U.S. PUBLIC LAND SURVEY MONUMENT RECORD


Note: This form is intended and designed to fulfill all requirements of Wisconsin Administrative Code, Chapter A-E 7.08 U.S. Public Land Survey Monument Record (3) (a) (b) (c) (d) (e) (f) (g) (h) (i). An additional sheet may be added if necessary to conform with said requirements.

(a) Corner location: Township 36 North

Range 7 East/West

Town/City/Village Woodboro

County Oneida

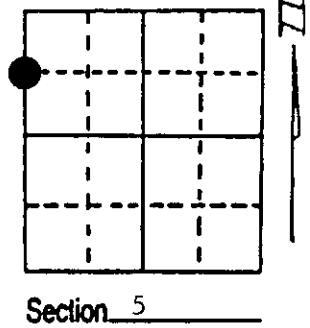

(b) (f) (g) (h) Description of monument found at this corner and if it was accepted, state all evidence (material, testimonial, occupational, plats, records, other monuments) used as a basis for accepting. If not accepted or if nothing was found, state evidence used as basis for establishing location. If reestablished through lost corner proportionate methods, indicate all monuments, distances and directions used to establish. Indicate type of monument found or set and sign post.

2/2/1982 - Jean Resvick (S-802) established this corner with a PK nail in road/two BTs:
4" Maple, S50°W, 53.76' 7" W. Birch, N55°W, 42.24'

5/24/1995 - Milo E. Stefan found both of Resvick BTs, Southwest a Maple, Northwest, a Birch stump.


We made two new BTs:
10" Maple, N42°W, 72.42' 10" Red Maple, N77°E, 60.94'

10/10/1995 - Milo E. Stefan returned and placed a railroad spike in surface of new blacktop - placed plastic sign post East, 32.8' and BT tags on each BT.

(c) (d) (e) Plan view of corner with ties to at least 4 witness monuments. If in disagreement with previously established corner, show the distances between the two corners and also indicate the ties to the disputed corner.

- 1) Railroad spike in road surface.
- 2) 10" Red Maple, N77°E, 60.94'.
- 3) 8" Red Maple, S50°W, 53.74'.
- 4) 10" Red Maple, N42°W, 72.42'.
- 5) 7" Birch Stump, N55°W, 42.24'.
- 6) Plastic Sign Post, East, 32.8'.

Distances to nail in side of BTs.
Stump blaze scribed "BT".
BT tags placed on face of each BT.

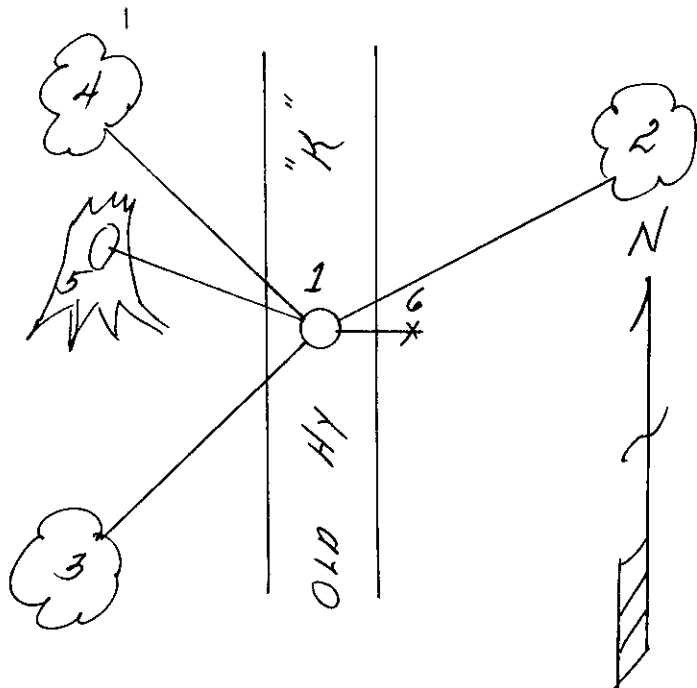

(i) I, Milo E. Stefan
(type or print name) certify that the corner location on this record was determined by me or under my direction and control and that this U.S. Public Land Survey Monument Record is correct and complete to the best of my knowledge and belief.

Milo E. Stefan
Signature

December 17, 1995

Date



Stamp
360706.3000

Index No. B-5