


# U.S. PUBLIC LAND SURVEY MONUMENT RECORD

Note: This form is intended and designed to fulfill all requirements of Wisconsin Administrative Code, Chapter A-E 5.02, U.S. Public Land Survey Monument Record (3) (a) (b) (c) (d) (e) (f) (g) (h) (i). An additional sheet may be added if necessary to conform with said requirements.

(a) Corner location: Township 36 North  
Range 7 East/West

Town/City/Village Woodboro  
County Oneida

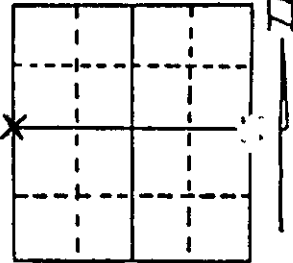

Section 10

(b) (f) (g) (h) Description of monument found at this corner and if it was accepted, state all evidence (material, testimonial, occupational, plats, records, other monuments) used as a basis for accepting. If not accepted or if nothing was found, state evidence used as basis for establishing location. If reestablished through lost corner proportionate methods, indicate all monuments, distances and directions used to establish.

November 1862 by Joseph H. Jenkins at 40.00 chains set post for 1/4 section corner:

6" Fir, N37°E, 20 links (13.20').


6" Fir, N66°W, 5 links (3.30').

July 29, 1937; Maine found remains of old post and original fir BT, N87°E, 20 links. He set county monument, a 2" x 60" galv. iron pipe/brass cap and scribed a 24" White Pine stump, N11°W, 37 links/"BT".

November 25, 1987 Milo E. Stefan found Maine's corner and cut new BT's and set sign post.

(c) (d) (e) Plan view of corner with ties to at least 4 witness monuments. If in disagreement with previously established corner, show the distances between the two corners and also indicate the ties to the disputed corner.

1. 2" x 36" galv. iron pipe with brass cap.
2. 6" Sugar Maple, N60°E, 29.65'.
3. 7" Sugar Maple, S38°E, 13.48'.
4. 6" Sugar Maple, S69°W, 53.26'.
5. 7" Red Maple, N32°W, 3.80'.
6. Plastic sign post, SE, 1.0'.  
BTs scribed "T36N R7E S(Section) BT".  
Distances measured to nail in side of tree.

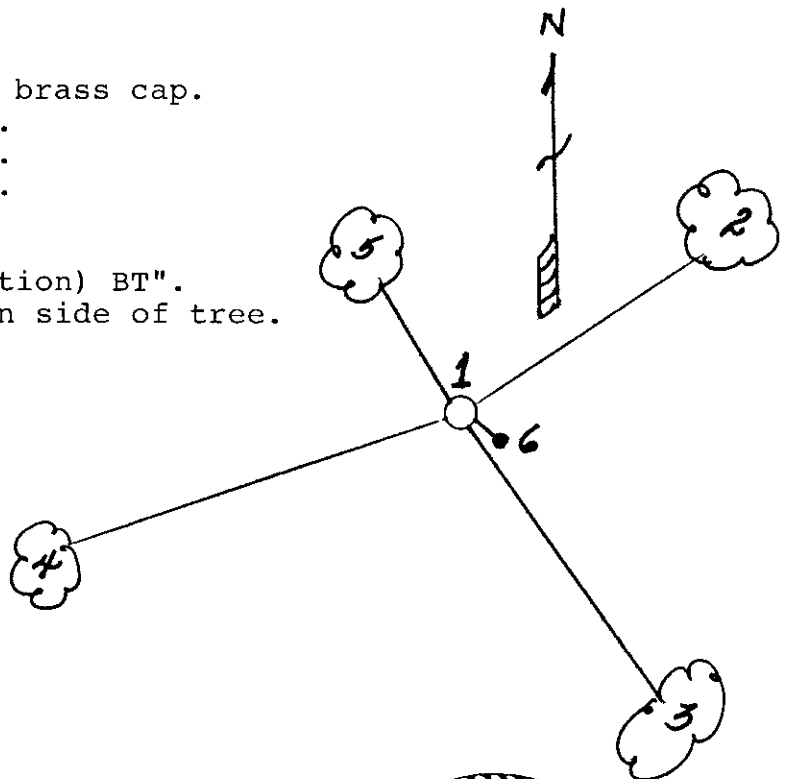

(i) I, Milo E. Stefan  
(type or print name) certify that the corner location on this record was determined by me or under my direction and control and that this U.S. Public Land Survey Monument Record is correct and complete to the best of my knowledge and belief.

Milo E. Stefan Signature  
12/6/87 Date



Index No. G-13

3607092000