U.S. PUBLIC LAND SURVEY MONUMENT RECORD

Note: This form is intended and designed to fulfill all requirements of Wisconsin Administrative Code, Chapter A-E 7.08 U.S. Public Land Survey Monument Record (3) (a) (b) (c) (d) (e) (f) (g) (h) (i). An additional sheet may be added if necessary to conform with said requirements.

(a) Corner location: Township 36 North

Range 7 East/~~West~~

~~Town/City/Village~~ Woodboro

County Oneida

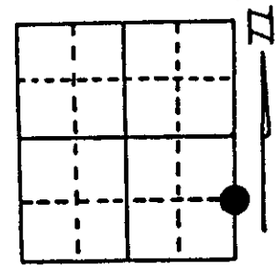

Section 14

(b) (f) (g) (h) Description of monument found at this corner and if it was accepted, state all evidence (material, testimonial, occupational, plats, records, other monuments) used as a basis for accepting. If not accepted or if nothing was found, state evidence used as basis for establishing location. If reestablished through lost corner proportionate methods, indicate all monuments, distances and directions used to establish. Indicate type of monument found or set and sign post.

Vaughan established this corner by survey from the M.C. Southerly and the Quarter Corner Northerly. He set a wood post with two BTs:
36" Pine Stump, N45°W, 2 Links (1.32') 24" Pine Stump, N70°W, 17½ Links (11.55')

7/9/1937 - Vern Maine found Vaughan corner at 15.44 chains North of the M.C. Southerly. He accepted this corner, did nothing.

12/1963 - James Griffen was here when he platted Nose Lake. I feel he replaced the wood post with a 1 1/2" x 24" iron pipe and he probably made one new BT, an 18" Pine Stump, S12°E, 11.3' as given on a deed filled in Volume 726, Page 628.

7/28/1995- Milo E. Stefan found an iron pipe marking the corner with remains of Vaughans BT, N45°W, 1.32' and an 18" Pine Stump, S12°E, 11.3' with scribing plain. We made new BTs and set plastic sign post.

(c) (d) (e) Plan view of corner with ties to at least 4 witness monuments. If in disagreement with previously established corner, show the distances between the two corners and also indicate the ties to the disputed corner.

1) 2" x 30" Aluminum Monument over 1 1/2" x 24" iron pipe.
2) 36" Pine Stump, N45°W, 1.32'-By Vaughan. (Very decayed - no scribing remains.)
3) 18" Pine Stump, S12°E, 11.3'-scribed by unknown parties.
4) 16" Red Oak, S10°E, 38.97'.
5) 12" White Spruce, S45°W, 38.61'.
6) Plastic Sign Post, North, .4'.

Distances to nail in side of BTs.
Stump blazes scribed "BT".
BT tags placed on each bearing tree.

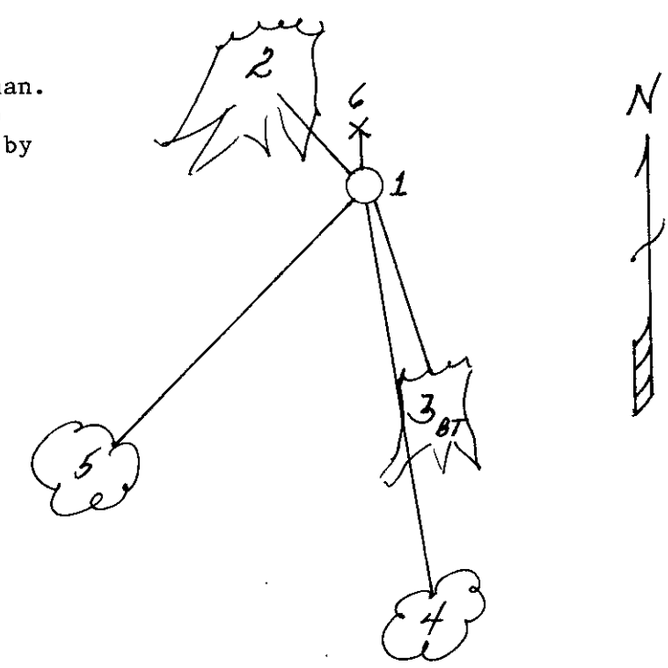

(i) I, Milo E. Stefan **(type or print name) certify that the corner location on this record was determined by me or under my direction and control and that this U.S. Public Land Survey Monument Record is correct and complete to the best of my knowledge and belief.**

Milo E. Stefan
Signature

September 11, 1995
Date

WISCONSIN MILO E. STEFAN S-1558 RHINELANDER, WIS. LAND SURVEYOR

Index No. M-21

3607141000