

U.S. PUBLIC LAND SURVEY MONUMENT RECORD


Note: This form is intended and designed to fulfill all requirements of Wisconsin Administrative Code, Chapter A-E 5.02, U.S. Public Land Survey Monument Record (3) (a) (b) (c) (d) (e) (f) (g) (h) (i). An additional sheet may be added if necessary to conform with said requirements.

(a) Corner location: Township 36 North

Range 7 East/West

Town/City/Village Woodboro

County Oneida

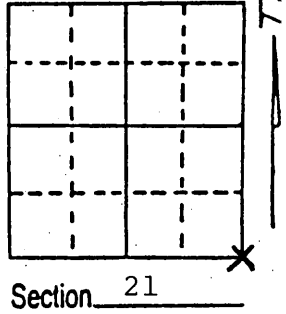

(b) (f) (g) (h) Description of monument found at this corner and if it was accepted, state all evidence (material, testimonial, occupational, plats, records, other monuments) used as a basis for accepting. If not accepted or if nothing was found, state evidence used as basis for establishing location. If reestablished through lost corner proportionate methods, indicate all monuments, distances and directions used to establish.

November 1862; Joseph H. Jenkins at 80.00 chains set post for section corner:


- 12" White Pine, N31°E, 28 links (18.48').
- 6" Fir, S68°E, 12 links (7.92').
- 8" Fir, S36°W, 12 links (7.92').
- 10" Fir, N32°W, 40 links (26.40').

September 11, 1937; Maine found old stake with stub of NE BT and decayed fir stumps nearly gone. He set county monument and called "X" on 5 1/2' x 6' grey boulder, N82°W, 136 links.

December 1, 1987; Milo E. Stefan found Maine corner. Boulder N82°W, 8.5' (Maine's distance is 13.6 links) "X" not located this day, moss on boulder frozen and snow covered.

(c) (d) (e) Plan view of corner with ties to at least 4 witness monuments. If in disagreement with previously established corner, show the distances between the two corners and also indicate the ties to the disputed corner.

1. 2" x 36" galv. iron pipe with brass cap.
2. 6" White Spruce, N17°E, 28.98'.
3. 6" White Spruce, S58°W, 22.53'.
4. 12" White Spruce, N22°W, 49.60'.
5. 5 1/2' x 6' Grey granite boulder N82°W, 8.67' (to NE tip of).
6. Plastic sign post SE 1.0'.
BTs scribed "T36N R7E S(section) BT".
Measurements to nail in side of tree.

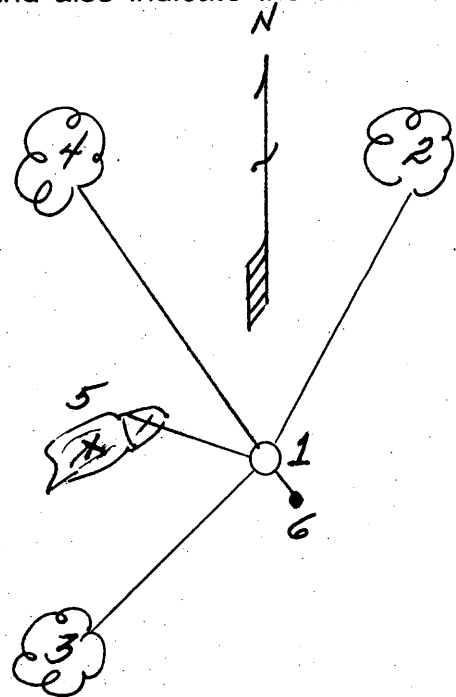

(i) I, Milo E. Stefan
(type or print name) certify that the corner location on this record was determined by me or under my direction and control and that this U.S. Public Land Survey Monument Record is correct and complete to the best of my knowledge and belief.

Milo E. Stefan
Signature

12/6/87
Date



Index No. 7-10

36007210000