# U.S. PUBLIC LAND SURVEY MONUMENT RECORD

**Note:** This form is intended and designed to fulfill all requirements of Wisconsin Administrative Code, Chapter A-E 7.08 U.S. Public Land Survey Monument Record (3) (a) (b) (c) (d) (e) (f) (g) (h) (i). An additional sheet may be added if necessary to conform with said requirements.

**(a) Corner location:** Township 36 North

Range 7 East/~~West~~

~~Town/City/Village~~ Woodboro

County Oneida

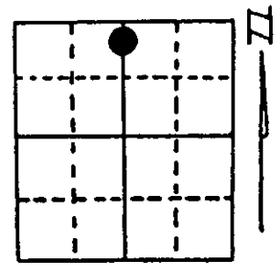

Section 23

**(b) (f) (g) (h) Description of monument found at this corner and if it was accepted, state all evidence (material, testimonial, occupational, plats, records, other monuments) used as a basis for accepting. If not accepted or if nothing was found, state evidence used as basis for establishing location. If reestablished through lost corner proportionate methods, indicate all monuments, distances and directions used to establish.** Indicate type of monument found or set and sign post.

1937 - Vern Maine restored position of the Quarter Corner to Sections 14 and 23, and set a 2" x 60" iron pipe with brass cap 1.5 chains South of Quarter Corner which falls in Finger Lake. He placed NO BTs that we are aware of.

8/29/1995 - Milo E. Stefan found Maine's monument and placed four bearing trees and a plastic sign post.

SUPPLEMENTAL INFORMATION ADDED 2/2/96:

- 1862 Joseph Jenkins calls for 1/4 corner in pond, sets witness on West side of pond: Birch 7", N25°E, 16 links; Birch 10", S20°W, 12 links.
- 1891 Dorr book 22, page 38, sets witness 1.5 chains South of 1/4 corner position in lake, Pine 26", N27½°E, 37 links.
- 1937 Maine book 1, page 181, found Dorr's BT, sets official corner; Black Oak 7", N63°W, .25½ chain.

**(c) (d) (e) Plan view of corner with ties to at least 4 witness monuments. If in disagreement with previously established corner, show the distances between the two corners and also indicate the ties to the disputed corner.**

1) 2" x 60" Iron pipe/brass cap.
2) 8" Red Oak, N77°E, 16.21'.
3) 8" Red Oak, S23°E, 22.36'.
4) 5" Red Oak, S48°W, 14.50'.
5) 12" Red Oak, N46°W, 4.75'.
6) Plastic Sign Post, West, .4'.

Distances to nail in side of BTs.
Stump blaze scribed "BT".
Bearing tree tags attached to BTs.

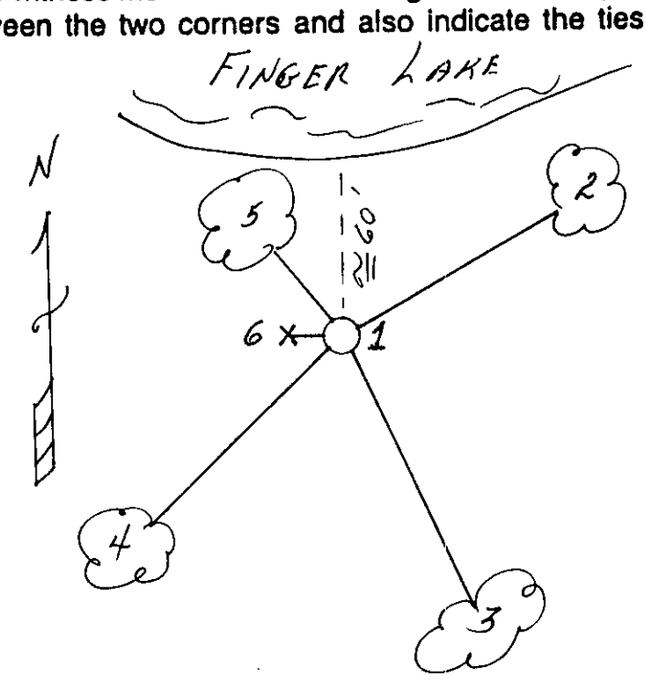


**(i) I,** Milo E. Stefan **(type or print name) certify that the corner location on this record was determined by me or under my direction and control and that this U.S. Public Land Survey Monument Record is correct and complete to the best of my knowledge and belief.**

Milo E. Stefan — September 11, 1995

Signature — Date

WISCONSIN MILO E. STEFAN S-1355 LAND SURVEYOR

Index No. N. 0 - 19

3607233520