


U.S. PUBLIC LAND SURVEY MONUMENT RECORD

Note: This form is intended and designed to fulfill all requirements of Wisconsin Administrative Code, Chapter A-E 7.08 U.S. Public Land Survey Monument Record (3) (a) (b) (c) (d) (e) (f) (g) (h) (i). An additional sheet may be added if necessary to conform with said requirements.

(a) Corner location: Township 36 North
 Range 7 East/West

Town/City/Village Woodboro

County Oneida

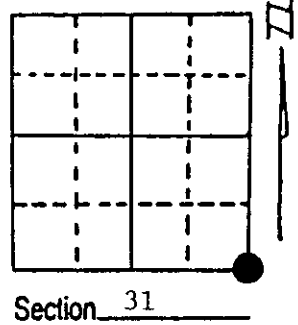

(b) (f) (g) (h) Description of monument found at this corner and if it was accepted, state all evidence (material, testimonial, occupational, plats, records, other monuments) used as a basis for accepting. If not accepted or if nothing was found, state evidence used as basis for establishing location. If reestablished through lost corner proportionate methods, indicate all monuments, distances and directions used to establish. Indicate type of monument found or set and sign post.

8/31/1860 - Alfred Millard established this corner and set a wood post with four BTs:
 9" Y. Pine, N77°E, 64 Links 12" Spruce Pine, S37°W, 55 Links
 20" W. Pine, S43°E, 27 Links 24" W. Pine, N49°W, 51 Links

10/22/49 - Wincentzen found 5" x 5" post and iron pipe along side.

7/31/89 - Milo E. Stefan found 5" x 5" post and 3/4" x 60" iron pipe along side.
 Supported by remains of original BTs:

Red Pine Stump, N77°E, 42.3'

Stump Hole, S37°W, 36.5'


Large White Pine Stump, N49°W, 21.5' (31 Links would fit) Error in original distance 51 to 31 Links.

We placed Oneida County Monument, made new BTs and set plastic sign post.

(c) (d) (e) Plan view of corner with ties to at least 4 witness monuments. If in disagreement with previously established corner, show the distances between the two corners and also indicate the ties to the disputed corner.

- 1) 2" x 30" Aluminum Oneida County Monument with 5" x 5" x 36" Cedar Post along side.
- 2) 10" White Birch, N3°E, 77.26'
- 3) 16" Red Oak, N76°E, 74.04'
- 4) 12" Aspen, S67°E, 22.62'
- 5) 14" Jack Pine, N71°W, 114.69'
- 6) Plastic sign post, NW, 1.0'

Distances to nail in side of BTs.
 BTs scribed "BT" in stump blaze.

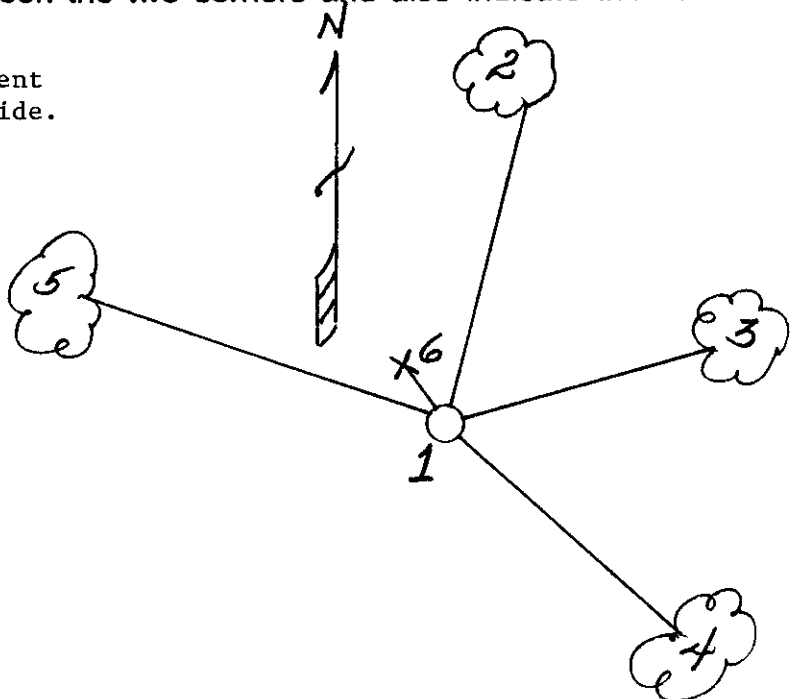

(i) I, Milo E. Stefan
 (type or print name) certify that the corner location on this record was determined by me or under my direction and control and that this U.S. Public Land Survey Monument Record is correct and complete to the best of my knowledge and belief.

Milo E. Stefan
 Signature

8/5/89
 Date



Index No. 7-5

3607310000