


U.S. PUBLIC LAND SURVEY MONUMENT RECORD ADDENDUM

Note: This form is intended and designed to fulfill all requirements of the Wisconsin Administrative Code, Chapter A-E 7.08 U.S. Public Land Monument Record (3)(a)(b)(c)(d)(e)(f)(g)(h)(i). An additional sheet may be added if necessary to conform with said requirements.

(a) CORNER LOCATION:  
Meander Corner north line of Section 18  
Township 36 North  
Range 8 East  
Town of Crescent  
County of Oneida

WISCRS - Oneida County  
North: 155834.509 USft  
East: 233851.040 USft  
Datum: NAD 83(2011) ep. 2010.00  
GNSS Method: RTN - Direct  
GNSS Control: WISCRS VRS  
The coordinate values shown have been verified by a series of gps observations made at markedly different times.

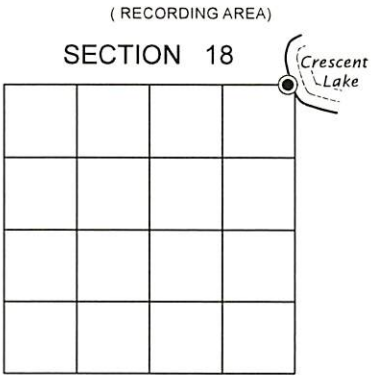

(b) HISTORY OF ORIGINAL CORNER ESTABLISHMENT  
Original Surveyor: William E. Daugherty, Deputy Surveyor set meander post  
Date of Survey: Commenced July 6, 1863  
Completed July 16, 1863  
Original B.T.'S: Hemlock 12" S 18°E, 39 links  
Sugar 19" N 2°W, 20 links


(f)(g)(h) DESCRIPTION OF MONUMENT FOUND AT THIS CORNER AND IF IT WAS ACCEPTED, STATE ALL EVIDENCE (MATERIAL, TESTIMONIAL, OCCUPATIONAL, PLATS, RECORD, OTHER MONUMENTS) USED AS A BASIS FOR ESTABLISHING LOCATION. IF NOT ACCEPTED OR IF NOTHING WAS FOUND, STATE EVIDENCE USED AS BASIS FOR ESTABLISHING LOCATION. IF REESTABLISHED THROUGH LOST CORNER PROPORTIONATE METHODS, INDICATE ALL MONUMENTS, DISTANCES AND DIRECTIONS USED TO ESTABLISH. INDICATE TYPE OF MONUMENT AND SIGN POST FOUND OR SET.

November 20, 1998 - Robert H. Winat, RLS No. 1040, Oneida County Certified Survey Map No. 2153, describes the Meander Corner, monumented by a found 1-1/2" diameter iron pipe.

December 14, 2023 - Michael S. Hess, PLS No. 809, Oneida County Certified Survey Map No. 5510, describes the Meander Corner, monumented by a found 1-1/2" diameter iron pipe.

October 10, 2025 - James D. Rein, PLS No. 1234, we recovered, and I accept as the best evidence of the original corner location, a 1-1/2" diameter iron pipe, at a position harmonious with the prior certified survey maps and replaced the iron pipe with an Oneida County capped 1" diameter x 30" long aluminum monument and made reference ties as shown in the plan.

(c)(d)(e) PLAN VIEW OF CORNER WITH TIES TO AT LEAST 4 WITNESS MONUMENTS. IF IN DISAGREEMENT WITH PREVIOUSLY ESTABLISHED CORNER, SHOW THE DISTANCE BETWEEN THE TWO CORNERS AND ALSO INDICATE THE TIES TO THE DISPUTED CORNER.

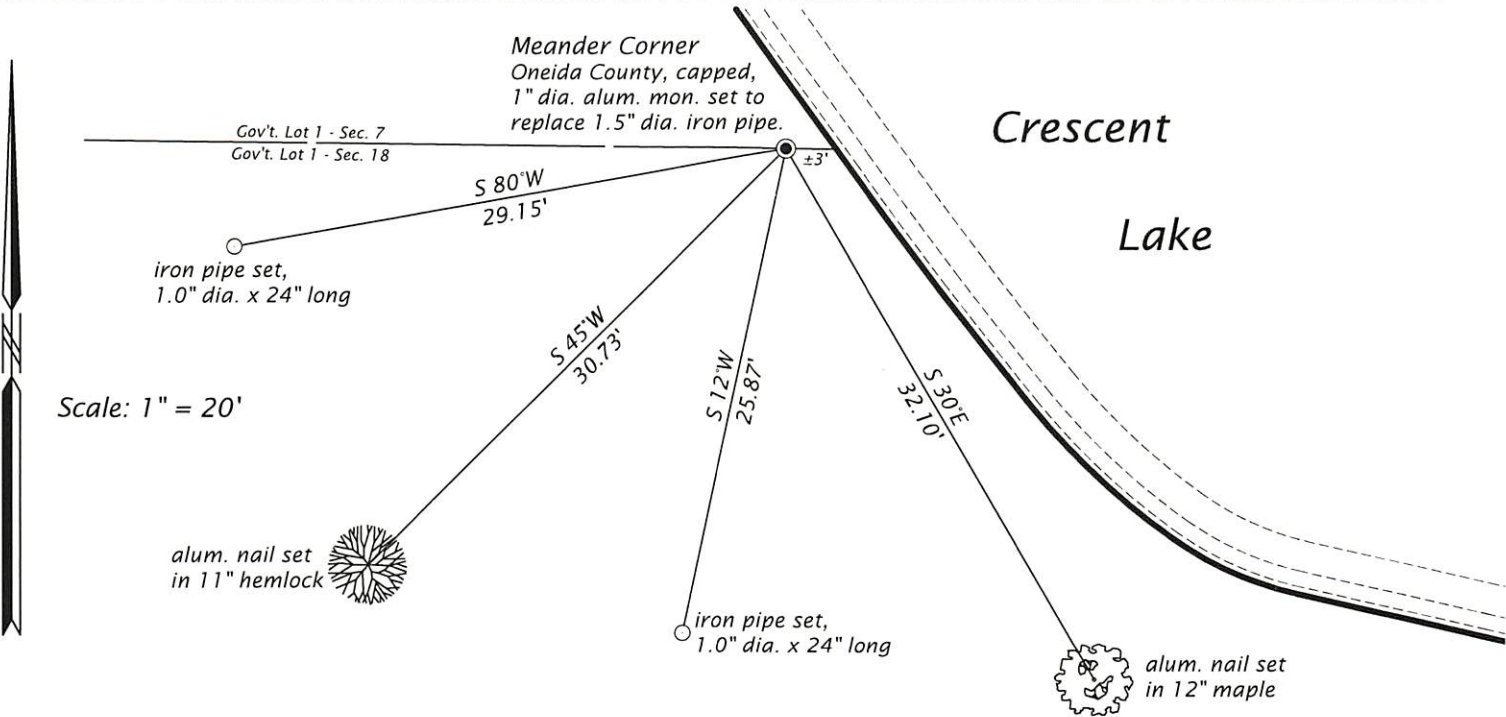

(i) I, JAMES D. REIN, PROFESSIONAL LAND SURVEYOR NO. S-1234 HEREBY CERTIFY THAT THE CORNER LOCATION ON THIS RECORD WAS DETERMINED BY ME OR UNDER MY DIRECTION AND CONTROL AND THAT THIS U.S. PUBLIC LAND SURVEY MONUMENT RECORD IS CORRECT AND COMPLETE TO THE BEST OF MY KNOWLEDGE AND BELIEF.

2/13/26

SIGNATUREDATE



INDEX NO. J - 4/5  
3608070005