

U.S. PUBLIC LAND SURVEY MONUMENT LOCATION RECORD

Recorders Data

USPLS CORNER: NORTH MC SECTION: 16 TOWNSHIP: 36 NORTH RANGE: 08 EAST
 NAME OF WATERWAY FOR M.C. CORNER: CRESCENT LAKE SECTION LINE: WEST
 (CITY)(VILLAGE)(TOWN) OF: CRESCENT COUNTY OF: ONEIDA

Description of monument found or placed and all other evidence used as the basis for monument location; including monuments and related measurements required if the corner location was reestablished by lost corner proportionate methods. Also indicate name of original surveyor, original survey date and the corner monument, bearing trees, witness or other reference monuments established; including measured bearing and distance ties, from available records.


Found and accepted a standard undisturbed 6" dia. concrete post monument with GLO 1939 stamped brass tablet in top 5" above grade. Also found a standard white poly 'T' marker post 10" East of the monument, which also falls on the upper edge of the 4' high original north bank of Crescent Lake which has accreted as wetland about 300 feet South to the existing lakeshore.

In July 1863, William E. Daugherty/GLO set a wood post as the original corner and marked new OBTs: a 10" Hemlock N62°E 10 links and a 12" Pw N72°W 12 links, all of which are now obliterated.

In September and October 1939, Hal Craig and Lester S. Mann/GLO, during their resurvey, per plat and notes filed as L-863 in Oneida County survey records, noted they had set a standard 6" dia. by 24" long concrete post, with stamped brass tablet in top, 18" into the ground at the original GLO survey meander corner location verified from the stump remains of both GLO OBTs, and marked new BTs: a 4" Or S63.25°E 18 links, now the West trunk of a twin 16" Or with blaze scars on West face; a 6" Pn S05°E 38 links, now a 13" Pr with plain lower blaze scar on North face; a 4" Poplar N54.25°E 19 links, now a 16" high 15" dia. sawed stump with no marks and a 4" Poplar N30.25°W 47 links, now gone.

This recovery completed May 10, 2000; there were no direct witnesses.

Plan view map of monument location with bearing and distance ties to a minimum of four(4) described witness or reference monuments of concrete, natural stone, iron, live bearing trees or equivalent material. If applicable, also show a minimum of two(2) bearing and distance ties to any other monument found and not accepted; including the bearing and distance from the accepted monument.

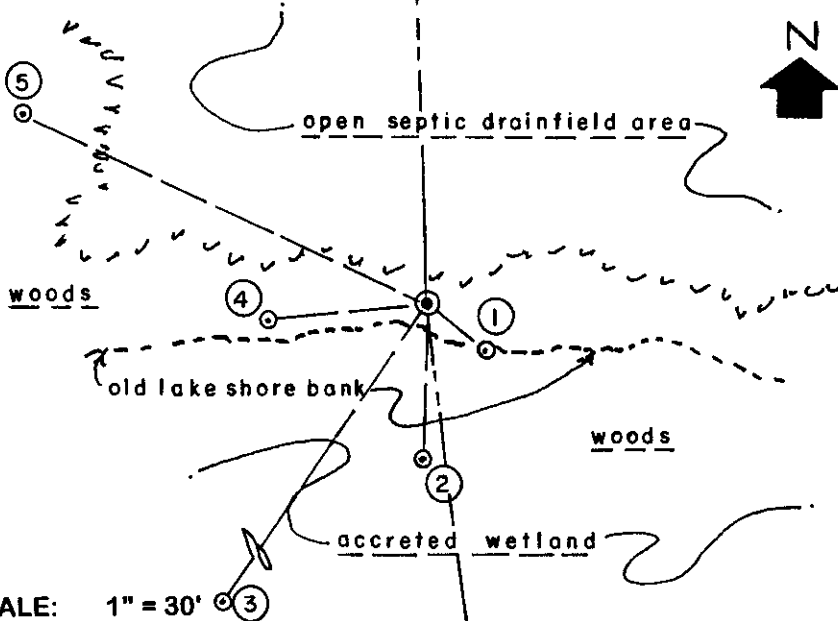


WITNESS MONUMENT TIES:

- ① 1939 GLO BT now West 16" Or of a twin Or S50°E 11.85'.
- ② 1939 GLO BT now 13" Pr S02°W 24.61'.
- ③ New BT 18" Pw S34°W 68.90'.
- ④ New BT North 9" Or of 3 Or S83°W 25.35'.
- ⑤ New BT 13" Or N65°W 69.05'.

SCALE: 1" = 30'

Unless otherwise indicated, all bearing tree ties are to a .25" dia. by 2.5" long PK nail with a 1.25" dia. steel washer driven into unblazed right face and a .25" dia. by 2.5" long PK nail with a 2" dia. steel washer stamped BT is also driven into unblazed face of bearing tree at DBH; the basis for measured bearings is by compass to nearest degree and all tie distances are measured horizontal by steel tape corrected to nearest 1/100th feet at standard temperature of 68° F.


RLS SEAL:

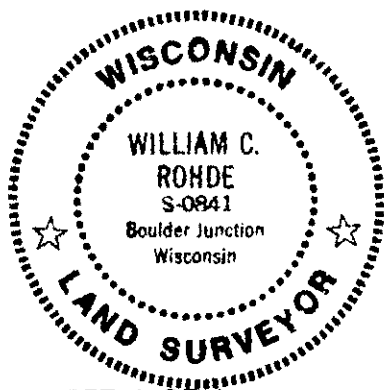

LAND SURVEYOR CERTIFICATE:

I, William C. Rohde, hereby certify that I am duly licensed as a Professional Land Surveyor in the State of Wisconsin; that this USPLS monument location was determined by me and/or under my direct supervision and control; and that this U.S. Public Land Survey Monument Location Record is true and correct to the best of my knowledge and belief.

Signed: *William C. Rohde*
 William C. Rohde RLS 841

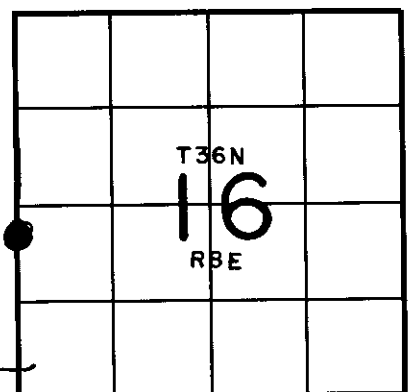

SECTION LOCATION MAP
 INDEX NO. LM-9

Date Signed: August 24, 2000

3608171300