

This form is intended to fulfill the requirements of Chapter A-E 7.08 (3)(a) thru (i) U.S. Public Land Survey Monument Location Record, Wisconsin Administrative Code. Use the reverse side of form for continuation.

U.S. PUBLIC LAND SURVEY MONUMENT LOCATION RECORD

USPLS CORNER: EAST MC SECTION: 30 TOWNSHIP: 36 NORTH RANGE: 8 EAST
 NAME OF WATERWAY FOR M.C. CORNER : LONG LAKE SECTION LINE: NORTH
 (CITY)(VILLAGE)(TOWN) OF: CRESCENT COUNTY OF: ONEIDA

Description of monument found or placed and all other evidence used as the basis for monument location; including monuments and related measurements required if the corner location was reestablished by lost corner proportionate methods. Also indicate name of original surveyor, original survey date and the corner monument, bearing trees, witness or other reference monuments established; including measured bearing and distance ties, from available records.

THIS CORNER WAS RE-REFERENCED WITH THE PRIOR VERBAL APPROVAL OF ONEIDA COUNTY SURVEYOR MICHAEL J. ROMPORTL, AS RECORD CORNER MONUMENT FOUND DISTURBED.


This corner was last referenced for record by Michael J. Romportl/RLS 1624 per his U.S. Public Land Survey Monument Location Record dated April 16, 1986 and filed in Oneida County records, which should be referred to for historical documentation.

I found 1942 GLO Resurvey brass capped 1.5" dia. galvanized iron pipe monument tipped 15°+- West and very loose in a cairn of rocks at grade on steep bank down to lakeshore 4 feet distant this date; I replumbed and secured the pipe monument with tamped soil backfill and replaced rocks as a cairn at grade; the brass cap is 18" up as I could not drive monument deeper due to probable anchoring and or refusal below grade. I also found a standard white poly "T" marker post East of the iron pipe monument which I pulled and reset along the SE Side of the pipe monument to further stabilize.

All of the 1986 record BTs have plain upper & lower face blaze scars, which I painted blaze orange and all were used for new ties to my standard PK nail/washer set into right face, in lieu of using old 60d spikes found as tie points in the old BTs.

This recovery completed November 19, 2002 and directly witnessed by adjoiner/owner Robert L. Lemke.

Plan view map of monument location with bearing and distance ties to a minimum of four(4) described witness or reference monuments of concrete, natural stone, iron, live bearing trees or equivalent material. If applicable, also show a minimum of two(2) bearing and distance ties to any other monument found and not accepted; including the bearing and distance from the accepted monument.

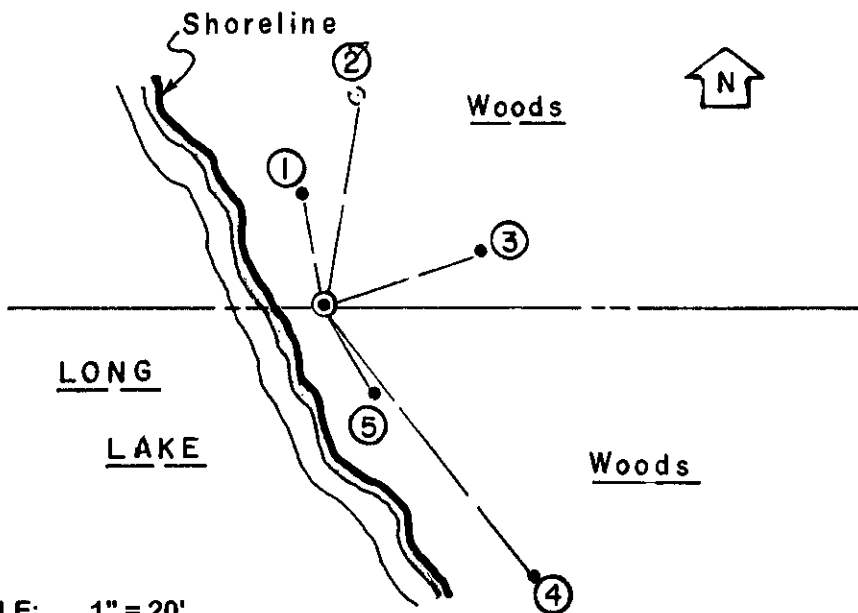


WITNESS MONUMENT TIES:

- ① Old 10" Oak BT N10°W 11.47'.
- ② Old 1942 GLO Resurvey Pine BT, now a dead 10' tall pike N10°E 22'+; I nailed a standard BT sign to upper face.
- ③ Old 8" Oak BT N70°E 17.40'.
- ④ Old 15" 1942 GLO Resurvey Pr BT S38°E 35.44'; I nailed a standard BT sign to upper face.
- ⑤ Old 11" Oak BT S30°E 10.54'.

SCALE: 1" = 20'

Unless otherwise indicated, all bearing tree ties are to a .25" dia. by 2.5" long PK nail with a 1.25" dia. steel washer driven into unblazed right face and a .25" dia. by 2.5" long PK nail with a 2" dia. steel washer stamped BT is also driven into unblazed face of bearing tree at DBH; the basis for measured bearings is by compass to nearest degree and all tie distances are measured horizontal by steel tape corrected to nearest 1/100th feet at standard temperature of 68° F.

RLS SEAL:

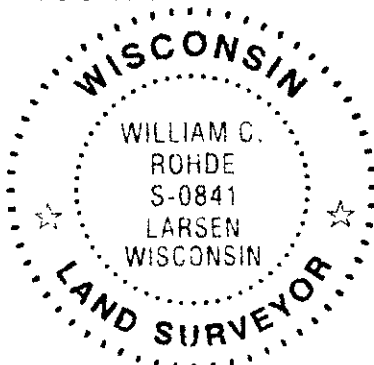

LAND SURVEYOR CERTIFICATE:

I, William C. Rohde, hereby certify that I am duly licensed as a Professional Land Surveyor in the State of Wisconsin; that this USPLS monument location was determined by me and/or under my direct supervision and control; and that this U.S. Public Land Survey Monument Location Record is true and correct to the best of my knowledge and belief.

Signed: *William C. Rohde*
 William C. Rohde RLS 841

		T 36 N	
		30	
		R 8 E	

SECTION LOCATION MAP
 INDEX NO. R 4-5

Date Signed: March 1, 2003

3608190015