U.S. PUBLIC LAND SURVEY MONUMENT RECORD


Note: This form is intended and designed to fulfill all requirements of Wisconsin Administrative Code, Chapter A-E 7 08 U.S. Public Land Survey Monument Record (3) (a) (b) (c) (d) (e) (f) (g) (h) (i). An additional sheet may be added if necessary to conform with said requirements.

(a) Corner location: Township 36 _North

East/West


Crescent Town/City/Village.

Oneida County _

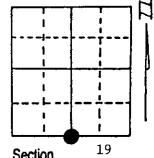

- (b) (f) (g) (h) Description of monument found at this corner and if it was accepted, state all evidence (material, testimonial, occupational, plats, records, other monuments) used as a basis for accepting. If not accepted or if nothing was found, state evidence used as basis for establishing location. If reestablished through lost corner proportionate methods, indicate all monuments, distances and directions used to establish. Indicate type of monument found or set and sign post.
 - 1863 William Daugherty established this corner and set a wood post with two BTs: 6" Maple, N60°E, 16 Links 8" Maple, S46°E, 24 Links
 - 7/27 10/1/1942 GLO Dependent Resurvey restored corner by lost methods and set a 6" x 24" concrete cylinder with two BTs: 12" Red Pine, S2½°W, 38 Links 8" Red Pine, N63°W, 11 Links
 - 7/28/89 Milo E. Stefan found GLO monument with BTs laying on ground, scribing visible. We made new BTs and set plastic sign post.
- (c) (d) (e) Plan view of corner with ties to at least 4 witness monuments. If in disagreement with previously established corner, show the distances between the two corners and also indicate the ties to the disputed corner.
 - 6" x 24" concrete GLO Monument 1)
 - 13" Red Pine, N67°E, 13.80' 2)
 - 3)
 - 14" White Pine, S87°E, 64.03' 14" White Pine, N40°W, 49.57' 4)
 - 9" Red Maple, N3°E, 37.84' 5)
 - Plastic sign post, South, .4'

Distances to nail in side of BTs. BTs scribed "BT" in stump blaze.

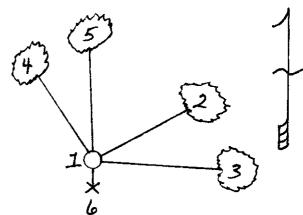

Milo E. Stefan

(type or print name) certify that the corner location on this record was determined by me or under my direction and control and that this U.S. Public Land Survey Monument Record is correct and complete to the best of my knowledge and belief.

Signature

8/5/89

Date

