

U.S. PUBLIC LAND SURVEY MONUMENT RECORD


Note: This form is intended and designed to fulfill all requirements of Wisconsin Administrative Code, Chapter A-E 7.08 U.S. Public Land Survey Monument Record (3) (a) (b) (c) (d) (e) (f) (g) (h) (i). An additional sheet may be added if necessary to conform with said requirements.

(a) Corner location: Township 36 North

Range 8 East/West

Town/City/Village Crescent

County Oneida

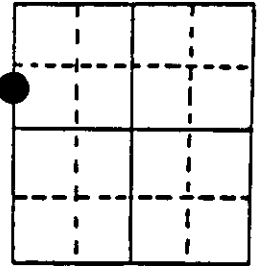

Section 29

(b) (f) (g) (h) Description of monument found at this corner and if it was accepted, state all evidence (material, testimonial, occupational, plats, records, other monuments) used as a basis for accepting. If not accepted or if nothing was found, state evidence used as basis for establishing location. If reestablished through lost corner proportionate methods, indicate all monuments, distances and directions used to establish. Indicate type of monument found or set and sign post.

1863 - Wm. Daugherty established this corner at 59.00 chains on south shore of a lake and set a wood post for the meander corner:
 10" Birch N65°E, 17 links (11.22')
 10" Birch N76°W, 16 links (10.56')


Late 1940's - County Surveyor, Wincentzen, found this corner in survey of government lot 3 and NE $\frac{1}{4}$ SE $\frac{1}{4}$ of Section 30. He stated he had BTs and left an iron pipe for M.C.

10/1992 - Milo E. Stefan ran the section line northerly from the Quarter Corner to Section 29 and 30 and parallel to the west line of a lot created by the Wincentzen survey. At the intersection of this line and south shore of Long Lake, a mound of stone painted with red paint was found. No indication of BTs were found or the iron pipe that Wincentzen said was here could be located. As the bearing and distance from the Quarter Corner to the mound of stone correspond, I placed an aluminum county monument and made new BTs and restored this Meander Corner.

(c) (d) (e) Plan view of corner with ties to at least 4 witness monuments. If in disagreement with previously established corner, show the distances between the two corners and also indicate the ties to the disputed corner.

- 1) 2" x 30" aluminum monument in mound of stone.
- 2) 4" Hemlock, S83°E, 16.74'.
- 3) 4" Hemlock, S21°E, 8.38'.
- 4) 9" Red Oak, S39°W, 25.63'.
- 5) 4" Hemlock, S63°W, 38.71'.
- 6) Plastic sign post, South, 4.5'.

Distances to nail in side of BTs.
 Stump blaze scribed "BT".

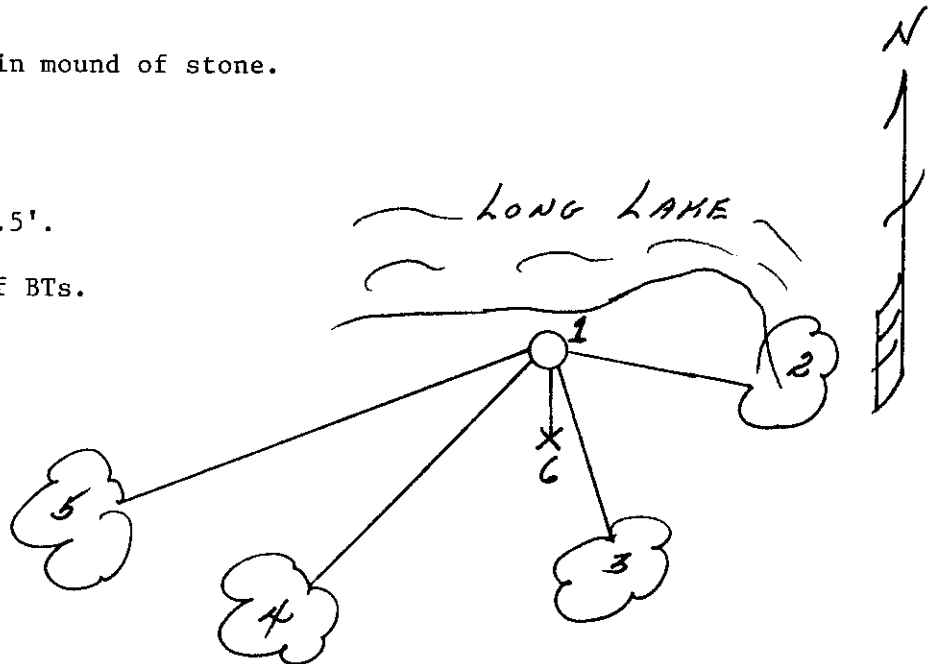

(i) I, Milo E. Stefan
 (type or print name) certify that the corner location on this record was determined by me or under my direction and control and that this U.S. Public Land Survey Monument Record is correct and complete to the best of my knowledge and belief.

Milo E. Stefan
 Signature

November 3, 1992
 Date



Stamp
 3608302600

Index No. S, T-5