


U.S. PUBLIC LAND SURVEY MONUMENT RECORD

Note: This form is intended and designed to fulfill all requirements of Wisconsin Administrative Code, Chapter A-E 7.08 U.S. Public Land Survey Monument Record (3) (a) (b) (c) (d) (e) (f) (g) (h) (i). An additional sheet may be added if necessary to conform with said requirements.

(a) Corner location: Township 36 North
 Range 8 East/West

Town/City/Village Crescent

County Oneida

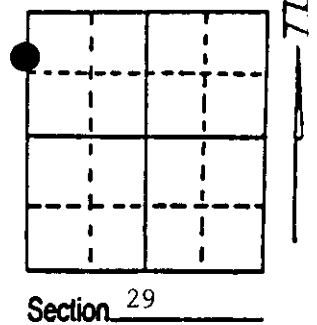

(b) (f) (g) (h) Description of monument found at this corner and if it was accepted, state all evidence (material, testimonial, occupational, plats, records, other monuments) used as a basis for accepting. If not accepted or if nothing was found, state evidence used as basis for establishing location. If reestablished through lost corner proportionate methods, indicate all monuments, distances and directions used to establish. Indicate type of monument found or set and sign post.


1863 - Wm. Daugherty established this corner on North shore of lake at 67.00 chains.
 Set wood post for Meander Corner and BTs:
 8" Tamarack, N48°E, 20 Lks (13.2') 8" Tamarack, S80°W, 31 Lks (20.46')

10/15/1992 - Milo E. Stefan found 3/4" iron pipe with very old down fence line ending on shore. Very decayed stumps from both original BTs are present. Position is Westerly from iron pipe about 3.8'. We set a 2" x 30" aluminum monument from original BT stumps; made new BTs and set sign post.

(c) (d) (e) Plan view of corner with ties to at least 4 witness monuments. If in disagreement with previously established corner, show the distances between the two corners and also indicate the ties to the disputed corner.

- 1) 2" x 30" aluminum monument.
- 2) 10" Tamarack, N3°E, 27.02'.
- 3) 10" Tamarack, N21°E, 12.76'.
- 4) 6" White Pine, S86°W, 20.39'.
- 5) 9" Tamarack, N30°W, 35.66'.
- 6) 3/4" Iron Pipe, East, 3.8'.
- 7) Plastic sign post
- 8) Original BT stump, N48°E, 13.2'.
- 9) Original BT stump, S80°W, 20.5'.

Distances to nail in side of BTs.
 Stump blazes scribed "BT".

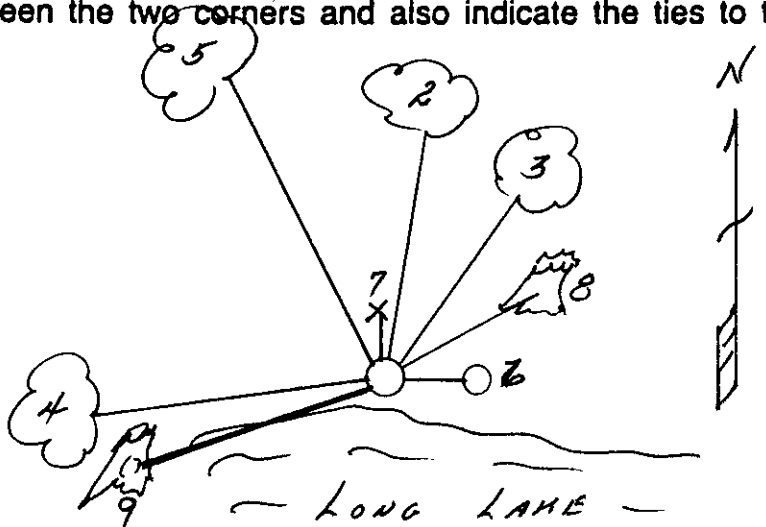

(i) I, Milo E. Stefan
 (type or print name) certify that the corner location on this record was determined by me or under my direction and control and that this U.S. Public Land Survey Monument Record is correct and complete to the best of my knowledge and belief.

Milo E. Stefan
 Signature

November 10, 1992
 Date



Index No. R, S-5

Stamp
 36083032cc