

CERTIFIED LAND CORNER RESTORATION

Index No. **2-5**

State of Wisconsin }
 County of Oneida } ss.

I, William E. Bandow, do hereby certify that on the 23rd day of January, 1981, I found evidence of the Southeast corner of Section 31 Township 36, North, Range 8 East, Fourth Principal Meridian, as described hereon; and that from this evidence I established a new monument and accessories as described hereon to perpetuate the original location of this corner.

Resident witnesses:

History of original corner establishment:

Corner set by Alex Anderson in 1860. West between Sections 5 & 32. 80.00 set post.

BT's
 White Birch 8" N 70°E 25 Links
 Yellow Pine 10" N 40°W 10 Links
 Yellow Pine 10" S 46°W 11 Links
 White Pine 10" S 24°E 28 Links

Description of corner evidence found:

No restorations on record.
 Found a 6"x6" red granite monument from which a Spruce bears N 58°W 25.5' (14") and a 16" Norway Pine bears N 68°E 18.5'.


Description of monument and accessories I established to perpetuate the original location of this corner.

Red granite monument remains in place. Made 1 new BT.

31 - 36 - 8

White Pine 12" S 20°W 33.7'

Distances are to center of trees.

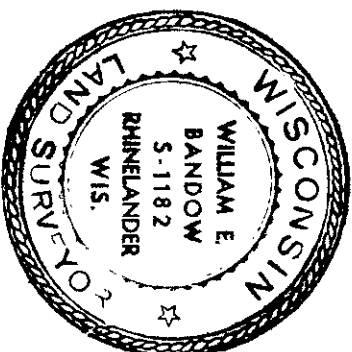

Dated at Rhineland, Wis., this 9th day of February, 1981.


Signature William E. Bandow Title Registered Land Surveyor Registration No. S. 1182
 (County Surveyor, Registered Land Surveyor, or other duly authorized official)

Office of Register of Deeds, County of Oneida
 I hereby certify that the within instrument was filed in this office for record on the 11 day of June, 1981 at 803 o'clock P M.

David Vorage Kumins
 (Register of Deeds)

By Supervisor A. S. S. S. Deputy

○ = Corner monument restored.

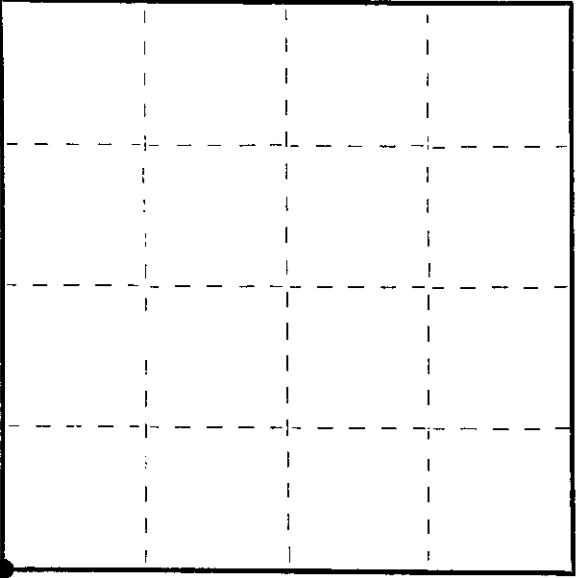

3608310000