U.S. PUBLIC LAND SURVEY MONUMENT RECORD

Note: This form is intended and designed to fulfill all requirements of Wisconsin Administrative Code, Chapter A-E 5.02, U.S. Public Land Survey Monument Record (3) (a) (b) (c) (d) (e) (f) (g) (h) (i). An additional sheet may be added if necessary to conform with said requirements.

(a) Corner location: Township 36 North

Range 8 East/~~West~~

Town/City/Village Town of Crescent

County Oneida

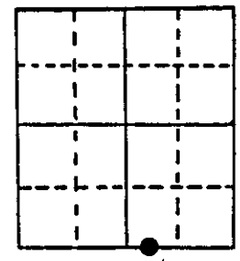

Section 34

(b) (f) (g) (h) Description of monument found at this corner and if it was accepted, state all evidence (material, testimonial, occupational, plats, records, other monuments) used as a basis for accepting. If not accepted or if nothing was found, state evidence used as basis for establishing location. If reestablished through lost corner proportionate methods, indicate all monuments, distances and directions used to establish.

Corner set by Alfred Millard in 1863. West between 3 & 34 34.50 to Wisconsin River & set meander post. BT Maple 12" S70W 14 lks. D.H. Vaughan at corner in 1898. He found original BT. We found a fence line leading to an old maple stub. Local resident Carl Rollman was told by his father this maple was a BT. They erected a fence from the BT east. Vaughan's distance from MC east to the south ¼ corner of Section 35 was 4880.7'. Our distance is 4884.05'. I set an aluminum monument at MC position. Maple stub bears S70W 9.2'.

(c) (d) (e) Plan view of corner with ties to at least 4 witness monuments. If in disagreement with previously established corner, show the distances between the two corners and also indicate the ties to the disputed corner.

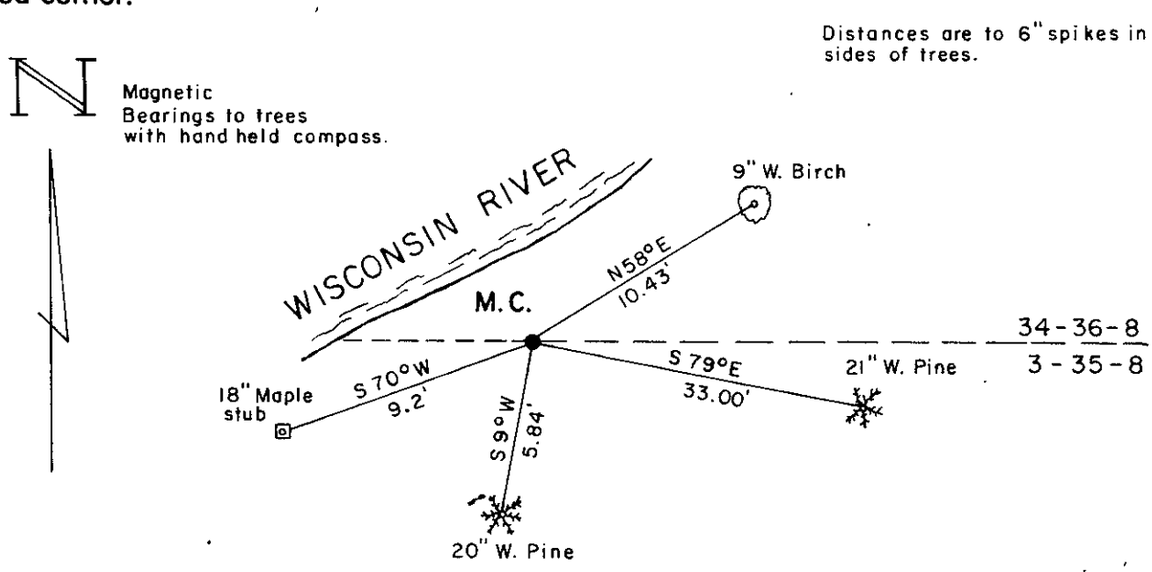

(i) I, William E. Bandow (type or print name) certify that the corner location on this record was determined by me or under my direction and control and that this U.S. Public Land Survey Monument Record is correct and complete to the best of my knowledge and belief.

William E. Bandow 12-5-84

Signature Date

WISCONSIN WILLIAM E. BANDOW S-1182 RHINELANDER WIS. LAND SURVEYOR

Index No. 2-15

3608 34 C016