


## US PUBLIC LAND SURVEY MONUMENT RECORD

Per Wis. Admin. Code § A-E 7.08, a U.S. public land survey monument record shall be prepared and filed with the county survey records as part of any land survey within 60 days of setting or accepting the corner, which includes or requires the perpetuation, restoration, or use of a U.S. public land survey corner and when any of the situations in Wis. Admin. Code § A-E 7.08(1)(a), (b) or (c) arise.

### 3(a) Corner Identification:

Found aluminum Oneida County 2" cap on a 1 1/4" iron pipe by Winat (1984)	Observed Coordinates: N: 156381.80 E: 272202.33
Witness MC	Datum: WISCRS
Section 09	GNSS Control: WISCRS NETWORK
Township 36 North	GNSS Method: RTK-Direct
Range 9 East	Verification Method: 2
4th Principal Meridian	
Town of Pelican	
Oneida Co., WI	

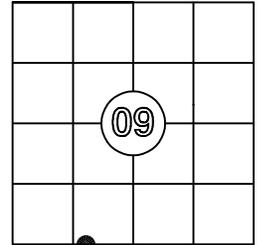

**CORNER ID:**  
**3609090028**


The coordinate value has been verified by at least one of the following methods: 1) comparison to a previously GNSS determined published value; 2) The value is the average of two or more GNSS observations at markedly different times; 3) one or more distances were measured to the corner from temporary GNSS observed offset locations.

### History of Original Corner Establishment

Corner Set: Wood Post  
Original Surveyor: Wm. Daugherty  
Date of Survey: August, 1863  
Ash, 7" S 6° E, 22 links  
Ash, 8" N 6° W, 25 links

### 3(b)((c)(d)(f)(g)(h)

- Original notes by Daugherty state that he set the meander post on the left bank of the Pelican River.
- 7/18/1983- Bob Winat, S-1040, during the course of surveying for the WiDoT Project I.D. No. 1593-1-21 (revised 1/16/1997), for the Rhinelander Belt Line, U.S.H. 8 right of way plat, shows that that he found a "MC-wood stake".
- 11/14/1983 - Bob Winat, S-1040, found a HUB & MC at this location.
- 10/13/1991 - Bob Winat, S-1040, sets an aluminum cap on an iron pipe, stamped to identify the witness meander corner, on the left bank of the Pelican River, 5.00' west of the meander corner.
- 11/13/1995 - Russ Brown, S-2148, finds an Oneida Co. monument
- 3/25/2016 - Chuck Oleinik, S-2439, find a 1" capped pipe witness corner.
- 11/1/2025 - I, Anthony Jones, S-2508, found Winat's aluminum cap on the iron pipe, leaning severely toward the river and loose. Using Winat's iron pipes to the west and dimensions from Oleinik's map, I re-set the aluminum capped iron pipe and drove it flush with the ground. It is on the edge of the river bank. The ground is very soft and the monument is likely to shift with passing freeze and thaw seasons. I made two additional witness trees, as shown below. A white guard post is east 0.5' from the monument.

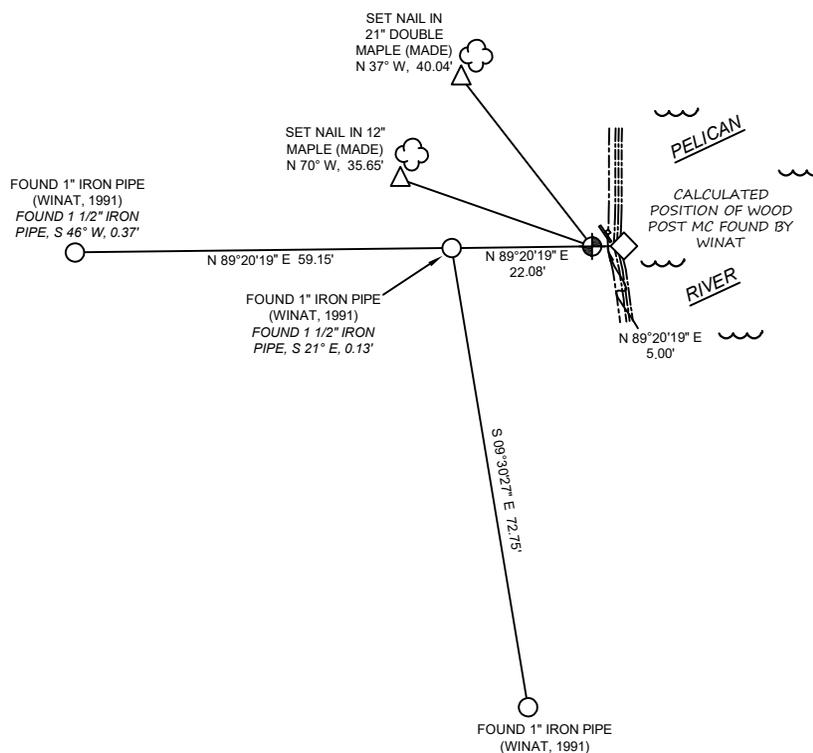

Bearings: Grid  
Scale: 1"=30'



### 3(i)

I, Anthony R. Jones, Wisconsin Professional Land Surveyor No S-2508, hereby certify that the corner location shown on this record was determined by me, or under my direction or control, and that this U.S. Public Land Survey Monument Record is correct and complete to the best of my knowledge and belief.

