U.S. PUBLIC LAND SURVEY MONUMENT RECORD

Note: This form is intended and designed to fulfill all requirements of Wisconsin Administrative Code, Chapter A-E 7.08 U.S. Public Land Survey Monument Record (3)(a-i).

(a) CORNER LOCATION
Witness Cor. of Secs. 13 & 18
Township 36 North
Range 9 & 10 East of the 4th P.M.
Town of Pelican
County of Oneida

WISCRS - Oneida County
N: 155,613.81 USft
E: 292,319.61 USft
Datum: NAD83(2011)
GNSS Method: RTN - Direct
GNSS Control: WISCORS VRS

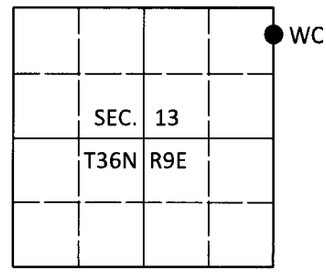

(b) HISTORY OF ORIGINAL CORNER ESTABLISHMENT

Original Surveyor:

Original Accessories:

Date of Survey Commenced:
Completed:

See previous monument record(s)

(b)(f)(g)(h) Description of monument found at this corner and if it was accepted, state all evidence (material, testimonial, occupational, plats, records, other monuments) used as a basis for accepting. If not accepted or if nothing was found, state evidence used as basis for establishing location. If re-established through lost corner proportionate methods, indicate all monuments, distances and directions used to establish. Indicate type of monument and sign post found or set.

This is a perpetuation of the following monument record(s) that comprise a complete history of the corner:

Sep. 19, 2007: USPLS Monument Record No. 3609120000 by Jonathan W. Dulin, RLS

June 25, 2019: I found and accepted the record monument, a 2.4" diam. aluminum pipe with a 3.3" diam. "witness monument" aluminum cap projecting 3" above the ground surface. I found the record reference monuments, but did not remeasure them due to overgrowth. I found or established accessories as shown below. I found a white vinyl sign post bearing South, 0.7 ft.

The coordinate value shown has been verified by at least one of the following methods: 1) comparison to a previously GPS determined published value; 2) the value is the average of two or more GPS observations at a markedly different time; 3) one or more distances were measured back to the GPS observed corner from temporary GPS observed offset locations.

(c)(d)(e) Plan view of corner with ties to at least 4 witness monuments. If in disagreement with previously established corner, show the distances between the two corners and also indicate the ties to the disputed.

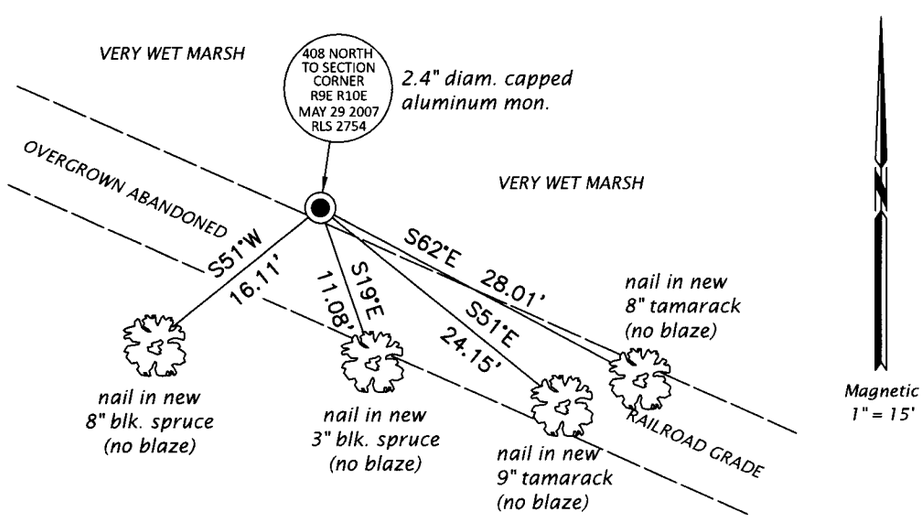

WISCONSIN
JEFFREY W. AUSTIN
S-1885
MINOCQUA, WI
LAND SURVEYOR

REGISTER OF DEEDS OFFICE
ONEIDA COUNTY
FILED

AUG 28 2019

KYLE J. FRANSON
REGISTER OF DEEDS

(i) I, Jeffrey W. Austin, Professional Land Surveyor No. S-1885, hereby certify that the corner location on this record was determined by me or under my direction and control and that this U.S. Public Land Survey Monument Record is correct and complete to the best of my knowledge and belief.

Signature JUL. 26, 2019
Date

3609133700 (INDEX NO. J,K-25)