


U.S. PUBLIC LAND SURVEY MONUMENT RECORD

Note: This form is intended and designed to fulfill all requirements of Wisconsin Administrative Code, Chapter A-E 7.08 U.S. Public Land Survey Monument Record (3) (a) (b) (c) (d) (e) (f) (g) (h) (i). An additional sheet may be added if necessary to conform with said requirements.

(a) Corner location: Township 36 North
 Range 9 East/West

Town/City/Village Pelican
 County Oneida

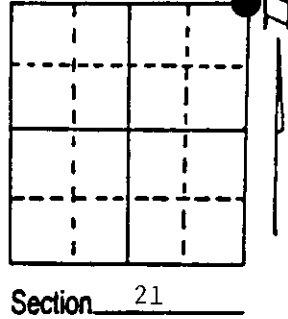


(b) (f) (g) (h) Description of monument found at this corner and if it was accepted, state all evidence (material, testimonial, occupational, plats, records, other monuments) used as a basis for accepting. If not accepted or if nothing was found, state evidence used as basis for establishing location. If reestablished through lost corner proportionate methods, indicate all monuments, distances and directions used to establish. Indicate type of monument found or set and sign post.

- 1863 - Wm. Daugherty established this corner and set a wood post.
- 1894 - Dorr restored this corner from original BTs and set a new post and two new BTs:
 12" Pine, S33½°E, 18 Links 10" Cedar, N86¼°W, 24½ Links
- 1961 - RIPCO subdivided Section 21 and made two new BTs:
 12" Hemlock, S39°E, 10.85 Feet 8" Cedar, N62°W, 12.35 Feet
- 5/21/1990 - Milo E. Stefan found post in mound of stone with remains of Dorrs BTs, now decayed stumps and RIPCO BTs in good condition. I placed a 2" x 36" aluminum monument and made two additional BTs.
- 12/1990 - Certificate prepared in 1982 has been misplaced and at the request of the county, I revisited the corner and found it in good condition and placed a plastic sign post.

(c) (d) (e) Plan view of corner with ties to at least 4 witness monuments. If in disagreement with previously established corner, show the distances between the two corners and also indicate the ties to the disputed corner.

- 1) 2" x 36" aluminum county monument in mound of stone
- 2) 6" Cedar, N38°E, 9.74 feet
- 3) 12" Hemlock, S39°E, 10.85 feet
- 4) 4" Cedar, S28°W, 22.30 feet
- 5) 8" Cedar, N62°W, 12.35 feet
- 6) Plastic sign post, NNE, 1.7 feet

Distances to nail in side of BTs.
 Stump blazes scribed "BT".

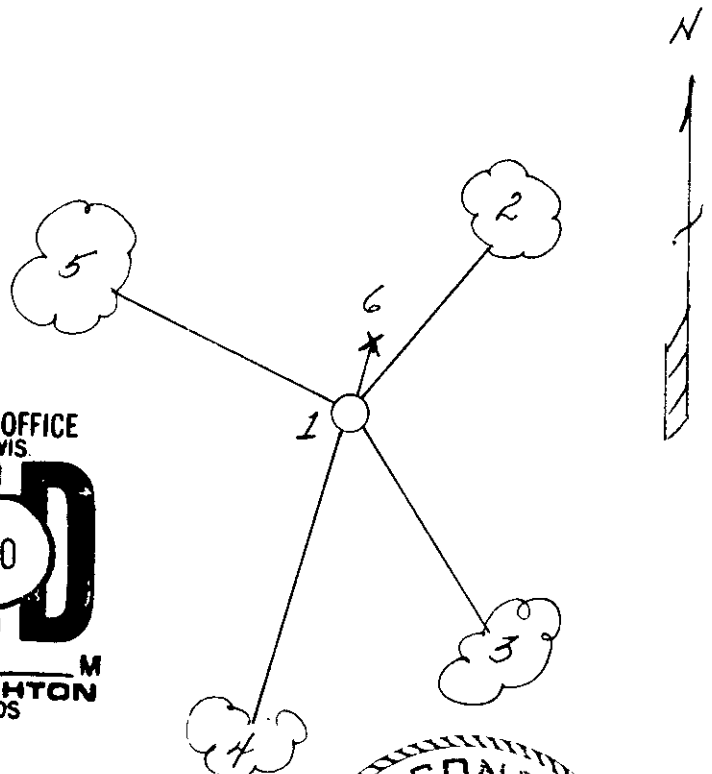

REGISTER OF DEEDS OFFICE
 ONEIDA COUNTY, WIS.
FILED
 DEC 12 1990
 At _____ O'Clock _____ M
THOMAS H. LEIGHTON
 REGISTER OF DEEDS

WISCONSIN
 MILO E. STEFAN
 S-1558
 RHINELANDER,
 WIS.
 LAND SURVEYOR

(i) I, Milo E. Stefan
 (type or print name) certify that the corner location on this record was determined by me or under my direction and control and that this U.S. Public Land Survey Monument Record is correct and complete to the best of my knowledge and belief.

Milo E. Stefan 12/5/90
 Signature Date

3609160000

Stamp

Index No. N-13