



CERTIFIED LAND CORNER RESTORATION

Index No. **P-13**

State of Wisconsin }
County of Oneida } ss.

I Philip T. Hansen, do hereby certify that on the 9th day of April, 1976, I found evidence of the quarter corner of Section 21 and 22 Township 36 East, Range 9 East, Fourth Principal Meridian, as described hereon; and that from this evidence I established a new monument and accessories as described hereon to perpetuate the original location of this corner.

Resident witnesses:
Glen Barker
Jim Claflin
Herb Wagoner

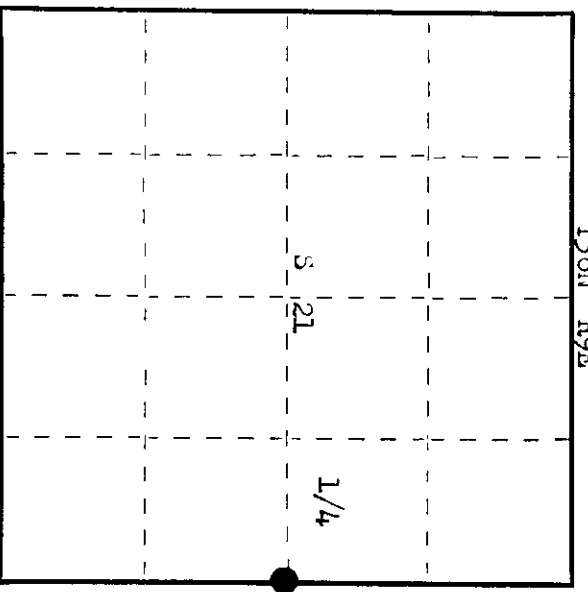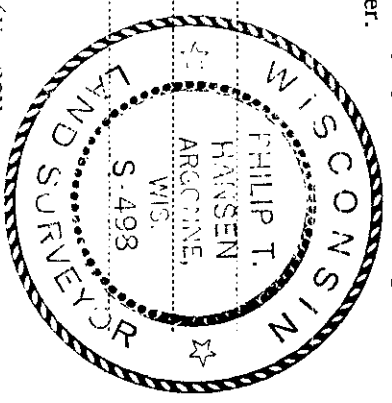

○ = Corner monument restored.

History of original corner establishment: Original Corner established by B. E. Duggerty, Deputy Surveyor, in 1863, from which Birch 7th bears N 24° W 40 lks and Birch 10th bears S 36° E 29 lks.
Corner reset by B.F. Dorr, County Surveyor.
Ripco Surveyor, Goddard, and crew recovered Corner in 1961. Set iron rod in road and a reference Corner 62 lks North. Set iron pipe with aluminum cap for witness monument. Corner is S 20° W 53.5 lks from telephone pole.

Description of corner evidence found: Recovered 2" iron pipe with aluminum cap stamped. Monument projects 24" above ground.
Unable to locate iron rod in road for 1/4 Corner.
Recovered point by intersection from witness monument and distance to telephone pole. Bearing to pole is wrong. We measure N 11° W instead of N 20° W. Corrected bearing and distance checks out perfectly.

T36N R9E
1/4
S21 | S22
Cor. 62 lks.

Description of monument and accessories I established to perpetuate the original location of this corner. Set a 1 1/2" x 30" iron pipe in blacktop for true corner, 4" below surface of road. as witness corner was in perfect condition, it was left in place.
Corner sets at south edge of River Bend Road.

NB0 - Hi Line Pole, 3609-21 N 28° E 84 lks.
Hi Line Pole 3609 -21 S 26° W 208.7 lks.
Measured distance to center of poles.

Dated at Rhineland, Wis., this 19th day of July, 1976

Signature: *Philip T. Hansen* Title Registered Land Surveyor Registration No. 3-498
County Surveyor, Registered Land Surveyor, or other duly authorized official

Office of Register of Deeds, County of Oneida
Instrument was filed in this office for record on the 23rd day of July, 1976 at 1:00 o'clock P.M.
I hereby certify that the within

Debra Venette Kishel
(Register of Deeds)

By: Deputy

3609212000


U.S. PUBLIC LAND SURVEY MONUMENT RECORD

Note: This form is intended and designed to fulfill all requirements of Wisconsin Administrative Code, Chapter A-E 7.08 U.S. Public Land Survey Monument Record (3) (a) (b) (c) (d) (e) (f) (g) (h) (i). An additional sheet may be added if necessary to conform with said requirements.

(a) Corner location: Township 36 North
 Range 9 East/West

Town/City/Village Pelican

County Oneida

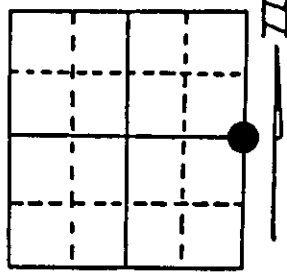

Section 21

(b) (f) (g) (h) Description of monument found at this corner and if it was accepted, state all evidence (material, testimonial, occupational, plats, records, other monuments) used as a basis for accepting. If not accepted or if nothing was found, state evidence used as basis for establishing location. If reestablished through lost corner proportionate methods, indicate all monuments, distances and directions used to establish. Indicate type of monument found or set and sign post.

1863 - Wm. Daugherty established this corner and set wood post/two BTs:
 7" Birch, N24°W, 40 Links (26.4') 10" Birch, S36°E, 29 Links (19.14')

1900 - B.F. Dorr reset corner.

1961 - Goddard and crew recovered corner and set iron rod for corner with aluminum cap on iron pipe as Witness Corner, North, 62 Links (40.92').


10/18/1982 - Milo E. Stefan found iron rod and made two new BTs:
 12" White Pine, N43°E, 51.88' 6" Jack Pine, S46°W, 72.40'

10/4/1994 - Milo E. Stefan returned to corner - found road resurfaced - rod gone. BT of 1982 okay. Witness Corner okay. We placed a new 2" x 36" aluminum monument 6" below the surface, just south of blacktop, made one new BT and placed plastic sign post.

(c) (d) (e) Plan view of corner with ties to at least 4 witness monuments. If in disagreement with previously established corner, show the distances between the two corners and also indicate the ties to the disputed corner.

- 1) 2" x 36" Aluminum Monument.
- 2) 1" x 24" High Aluminum Capped Iron Pipe, North, 40.92'.
- 3) 12" White Pine, N43°E, 51.88'.
- 4) 6" Jack Pine, S33°E, 104.28'.
- 5) 6" Jack Pine, S46°W, 72.40'.
- 6) Plastic Sign Post, North, 42.0'.


Distances to nail in side of BTs.
 Stump blazes scribed "BT".

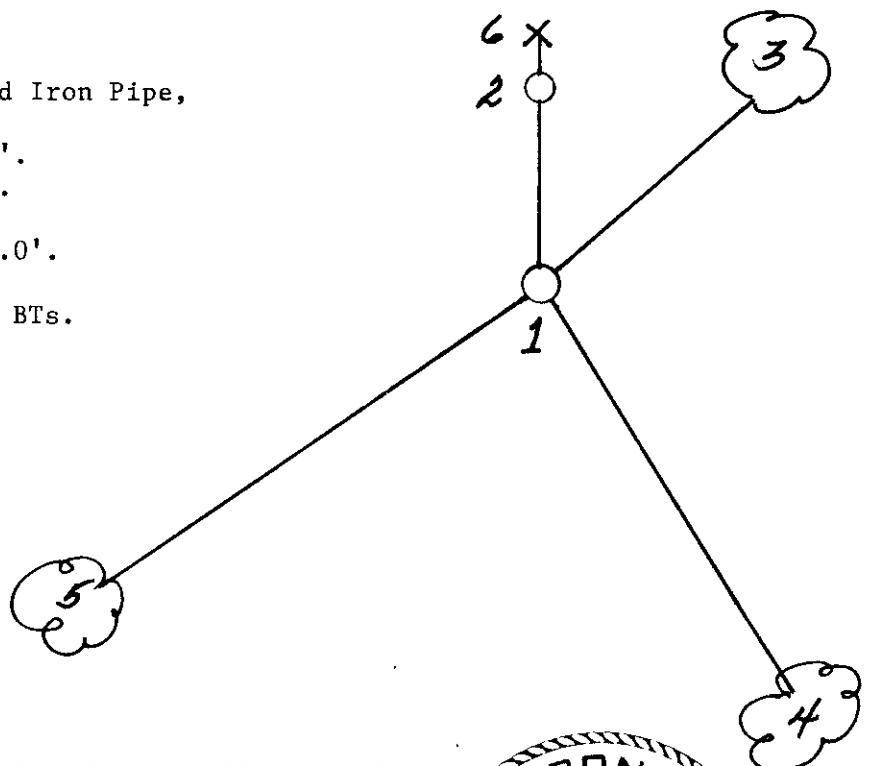

(i) Milo E. Stefan
 (type or print name) certify that the corner location on this record was determined by me or under my direction and control and that this U.S. Public Land Survey Monument Record is correct and complete to the best of my knowledge and belief.

Milo E. Stefan
 Signature

10/11/94
 Date

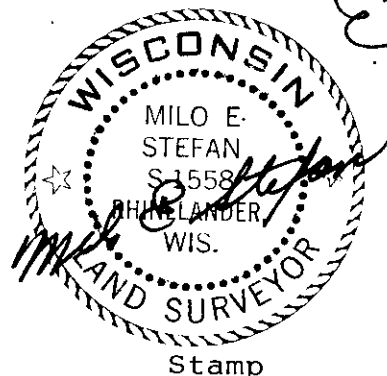

Stamp

Index No. P-13

3609212000