

This form is intended to fulfill the requirements of Chapter A-E 7.08 (3)(a) thru (i) U.S. Public Land Survey Monument Location Record, Wisconsin Administrative Code. Use the reverse side of form for continuation.

Recorders Data

U.S. PUBLIC LAND SURVEY MONUMENT LOCATION RECORD

USPLS CORNER: NORTH 1/4 CORNER SECTION: 25 TOWNSHIP: 36 NORTH RANGE: 09 EAST

NAME OF WATERWAY FOR M.C. CORNER: N/A SECTION LINE: N/A

(CITY)(VILLAGE)(TOWN) OF: PELICAN COUNTY OF: ONEIDA

Description of monument found or placed and all other evidence used as the basis for monument location; including monuments and related measurements required if the corner location was reestablished by lost corner proportionate methods. Also indicate name of original surveyor, original survey date and the corner monument, bearing trees, witness or other reference monuments established; including measured bearing and distance ties, from available records.

Found and accepted an older 1.5" dia. galvanized iron pipe with loose stamped cap 22" above grade and tipped SE about 15°. I removed the 48" long pipe monument to reveal the plumb soil cavity below grade and reset the corner with a 2" dia. by 30" long standard aluminum monument with stamped Oneida County cap 8" above grade and secured by tamping for new ties. I left the old corner pipe monument flat on grade nearby.

In August 1865, William E. Daugherty/GLO set a wood post as the original corner and marked new OBT: 14" Aspen N73°E 6 links only as he noted no others near; all now obliterated.


In 1969, George Drivas of Regis Paper Company notes a monument at this corner by Rhinelander Paper Company per Plat of Survey L-254 in Oneida County survey records; monument found presumably set by the latter paper company.

In March 1992, Milo E. Steffan/RLS 1558 notes "Found restored GLO corner" per Plat of Survey B-2396 in Oneida County survey records; Steffan undoubtedly tied corner to older BTs I found, but has filed no USPLS Location Record to date.

Steffan's 1992 survey was completed for adjoining owner Roland Rueckert, whom I met in the field this date and he walked me to this corner location with capped iron pipe, which he identified had been used by Steffan as the North 1/4 corner of Section 25 during his survey.

This recovery completed November 2, 2001.

Plan view map of monument location with bearing and distance ties to a minimum of four(4) described witness or reference monuments of concrete, natural stone, iron, live bearing trees or equivalent material. If applicable, also show a minimum of two(2) bearing and distance ties to any other monument found and not accepted; including the bearing and distance from the accepted monument.

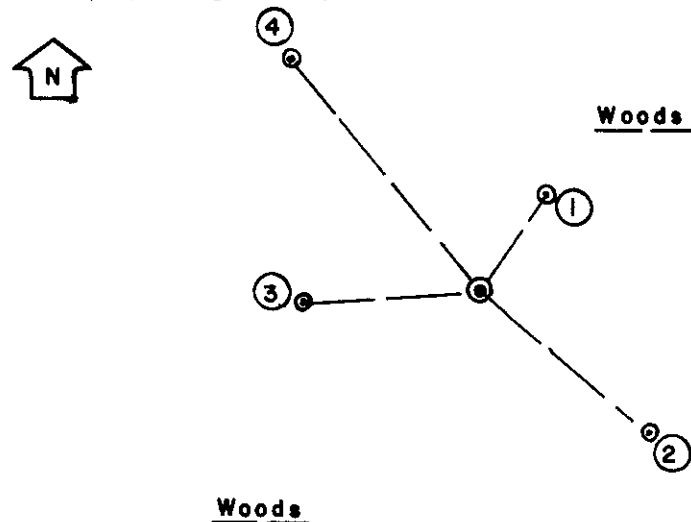

WITNESS MONUMENT TIES:

- ① - Old BT 9" Pw with long lower face blaze open and scribed N35°E 12.05'.
- ② - Old BT 12" Pr with upper & lower blaze scars S50°E 23.21'.
- ③ - Old BT 12" Pw with lower blaze open and upper blaze scar plain S87°W 18.28'.
- ④ - Old BT 12" Pw with upper & lower blazes open & scribed N40°W 31.41'.

Older BTs found not of public record and a 20d aluminum nail found in right face of all BTs were not used for ties.

Standard white poly 'T' corner marker post set 3" South of corner monument.

SCALE: 1" = 20'

Unless otherwise indicated, all bearing tree ties are to a .25" dia. by 2.5" long PK nail with a 1.25" dia. steel washer driven into unblazed right face and a .25" dia. by 2.5" long PK nail with a 2" dia. steel washer stamped BT is also driven into unblazed face of bearing tree at DBH; the basis for measured bearings is by compass to nearest degree and all tie distances are measured horizontal by steel tape corrected to nearest 1/100th feet at standard temperature of 68° F.

RLS SEAL:




LAND SURVEYOR CERTIFICATE:

I, William C. Rohde, hereby certify that I am duly licensed as a Professional Land Surveyor in the State of Wisconsin; that this USPLS monument location was determined by me and/or under my direct supervision and control; and that this U.S. Public Land Survey Monument Location Record is true and correct to the best of my knowledge and belief.

Signed: *William C. Rohde*
William C. Rohde RLS 841

Date Signed: March 25, 2002

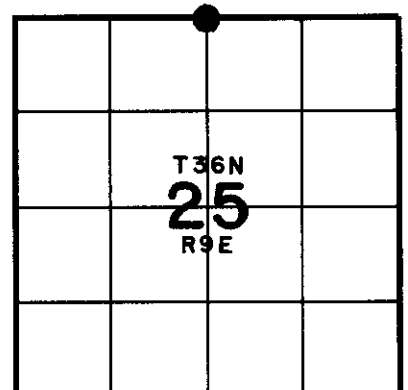

SECTION LOCATION MAP
INDEX NO. R 25