

CERTIFIED LAND CORNER RESTORATION



Index No. Z-21

State of Wisconsin

County of Oneida } ss.

I Phillip T. Hansen, do hereby certify that on the 31st day of August, 1979, I found evidence of the Section corner of Sections 35, 36, 1 and 2 Township 36, North, Range 9 East, Fourth Principal Meridian, as described hereon; and that from this evidence I established a new monument and accessories as described hereon to perpetuate the original location of this corner.

Resident witnesses:
Glen Barker
Jim Claflin
Herb Wagoner

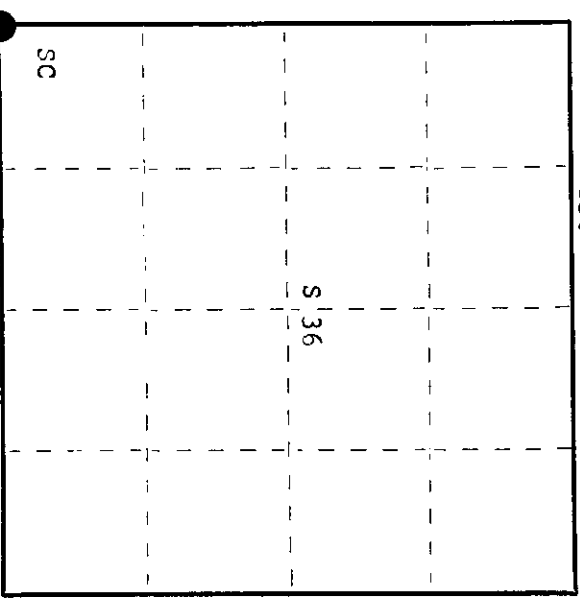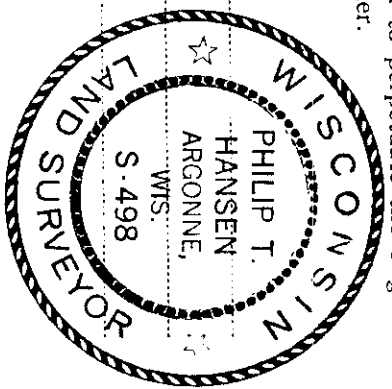

○ = Corner monument restored.

History of original corner establishment:

Original corner established by Wm. E. Dougherty, Deputy Surveyor, in 1863, from which Birch 13" bears N37°W 14 links; Hemlock 12" bears N12°E 10 links; Fir 6" bears S65°E 7 links; Birch 10" bears S45°W 12 links.

Corner subsequently restored by Oneida County survey.

Corner recovered in 1959 by Ripco surveyors. Recovered the iron pipe set by county survey crew.

Description of corner evidence found:

Recovered 2-1/2" iron pipe with screw in brass cap, projecting 30" above ground. Cap stamped: Also recovered a piece of an old squared stake laying beside it.

Recovered BPT's -

- Hemlock 20" east 8.4 links, scribe mark B visible.
- Cedar 10" S35°E 39.1 links, R.T. visible.
- No records on these BPT's.

T36 R9
 S35 S36
 S2 S1
 T35N R9E

Description of monument and accessories I established to perpetuate the original location of this corner. Left the county monument in place as recovered.

Marked NBT -

- Cedar 10" S61°W 52.7 links
- Maple 6" N40°W 22.5 links, scribed SC BT.

Dated at Rhinelander, Wis., this 10th day of September, 1979

Signature: Phillip T. Hansen Title: Registered Land Surveyor Registration No. S-498
 (County Surveyor, Registered Land Surveyor, or other duly authorized official)

Office of Register of Deeds, County of Oneida, I hereby certify that the within instrument was filed in this office for record on the 17th day of September, 1979 at 1:05 o'clock P. M.

Doris Savage Tucker
 (Register of Deeds)

By: 3609350000 Deputy