

CERTIFIED LAND CORNER RESTORATION



Index No. W-24

State of Wisconsin

County of Oneida } ss.

I Philip T. Hansen, do hereby certify that on the 13th day of April, 1976, I found evidence of the NE 1/16 corner of Section 36, Township 36, North, Range 9, East, Fourth Principal Meridian, as described hereon; and that from this evidence I established a new monument and accessories as described hereon to perpetuate the original location of this corner.

Resident witnesses:
Glen Barker
Jim Clafin
Herb Wagoner

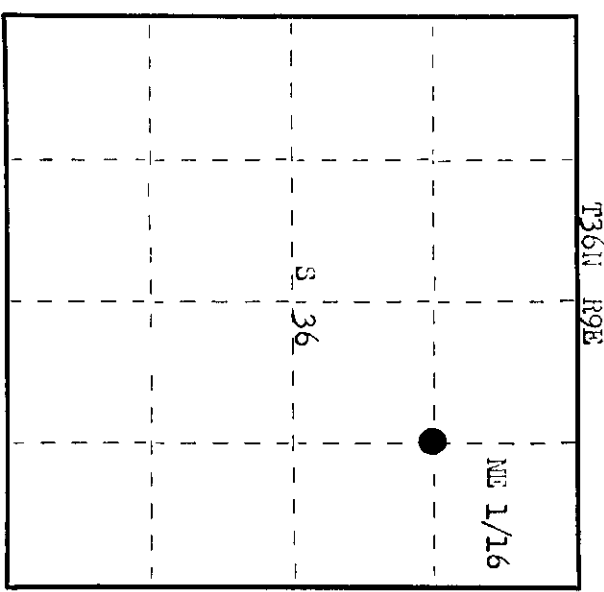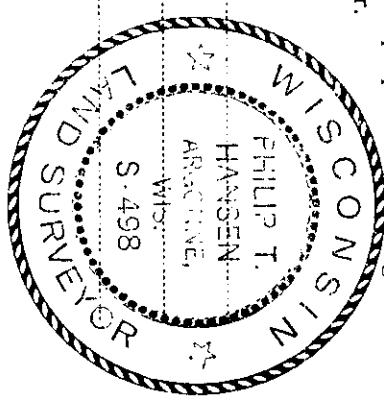

○ = Corner monument restored.

History of original corner establishment: Corner established by Ripco survey, or, Drivers, and crew in 1959. Ran a random line E-C 1/16 Corner previously set 41.72 chains bearing 350° 44', closed out 11 lks west of E 1/16 on North line. Set NE 1/16 Corner at 20.80 chains, equidistant. Set 4 x 4 squared reference post 10 links east of corner. Hub in road for corner, corrected bearing N 30° 47' W. Marked BTS - Maple 5" N 80° E 16 lks, Y. Birch 7" N 41° W 41 lks.

Description of corner evidence found: Recovered 1/2" iron rod buried in east edge of road, 6" below surface. A 4" cedar post, scribed Cor 10 Lk W, NE 1/16 S36, was recovered 10 lks east. Also recovered a 1" iron pipe with 2" square brass cap on the south side of post stamped Cor. 10 lks W, NE 1/16 S36 RIPCO. The distance to the iron rod buried in road was good. Recovered BTS - Maple 5" N 80° E (N 80° E) 16 lks (15.2 lks). Y. Birch 7" (8") N 41° W (N 38° W) 41 lks (49 lks).

Description of monument and accessories I established to perpetuate the original location of this corner. We removed the pipe and post and reset the pipe in the hole of post. Propped old post beside it. Added T36N R9E to stapping on brass cap.

NBT - Hemlock 8" S 22° W 50.7 lks, scribed 1/16 BT. Reference monument and BTS painted blue.

Dated at Rhinelander, Wis., this 19th day of July, 1976.

Signature Philip T. Hansen Title Registered Land Surveyor Registration No. S-498
(County Surveyor, Registered Land Surveyor, or other duly authorized official)
Office of Register of Deeds, County of Oneida.
Instrument was filed in this office for record on the 23rd day of July, 1976 at 100 o'clock P. M.

Signature Donna DeAngelis Deputy
(Register of Deeds)

By Donna DeAngelis Deputy
3609363010