

CERTIFIED LAND CORNER RESTORATION

Index No. E-18

State of Wisconsin

County of Oneida } ss.

I Phillip T. Hansen, do hereby

certify that on the 12th day

of January, 1979, I found

evidence of the W 1/16

corner of Section 2 & 11

Township 36, North, Range

10 East, Fourth Principal Meridian,


as described hereon; and that from this evidence

I established a new monument and accessories

as described hereon to perpetuate the original

location of this corner.

T36N R10E

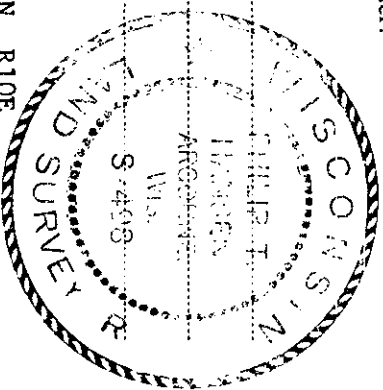


Resident witnesses:

Glen Barker

Jim Clafflin

Herb Wagoner

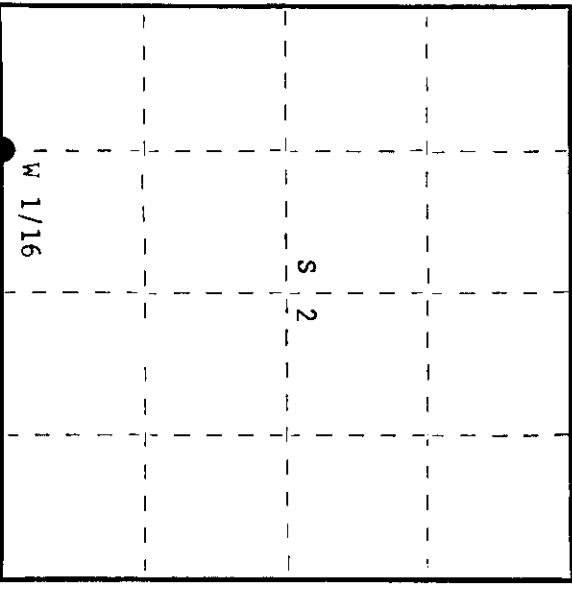

○ = Corner monument restored.

History of original corner establishment:

Corner established by D.H. Vaughan, County surveyor, in 1897.

Marked BT's - Black Ash 14" S82°W 23 links

Cedar 10" N65°E 6 links.

Corner recovered by H. C. Lawrence, Registered Land Surveyor, in 1947.

Found Vaughan's old post and BT's intact.

Description of corner evidence found:

Recovered H.C. Lawrence's 6" squared post, not scribed, standing in poor condition.

Recovered OBT's -

Black Ash 14" (18") S82°W (S89°W) 23 links, scribing rotted out.

Cedar 10" (12") N65°E (N69°E) 6 links, scribed 1/8S BT.

Description of monument and accessories I established to perpetuate the original location of this corner.

Replaced cedar post with 1 1/2" iron pipe with 2" diameter brass cap, stamped:

Monument projects 12" above ground.

Marked NBT's -

Cedar 6" due north 21.9 links, scribed 1/16 BT.

S498
T36N R10E
W 1/16 S 2
S 11
CPI-1979

Dated at Rhinelander, Wis., this 18th day of January, 1979

Signature Phillip T. Hansen Title Registered Land Surveyor Registration No. S-498

Office of Register of Deeds, County of Oneida

Instrument was filed in this office for record on the 31st day of January, 1979

at 2:30 o'clock P.M.

By Dona Verage Kuehn Deputy

3610020030