



CERTIFIED LAND CORNER RESTORATION

Index No. **E 16**

State of Wisconsin

County of Oneida } ss.

I, Philip T. Hansen, do hereby certify that on the 15th day of August 1975, I found evidence of the E-1/16 corner of Sections 3 and 10 Township 36 North, Range 10 East, Fourth Principal Meridian, as described hereon; and that from this evidence I established a new monument and accessories as described hereon to perpetuate the original location of this corner.

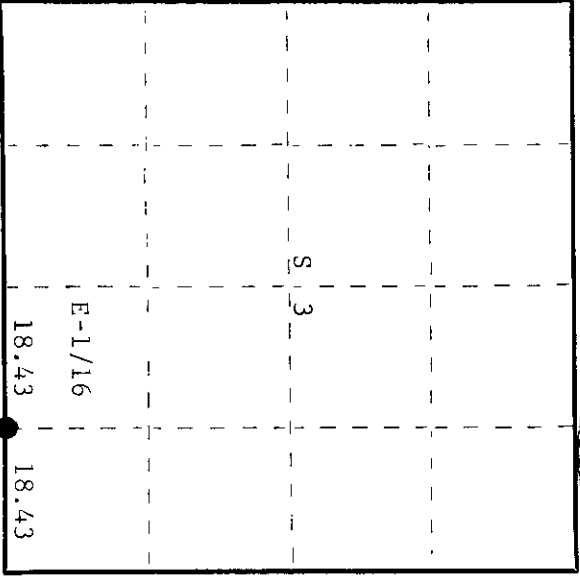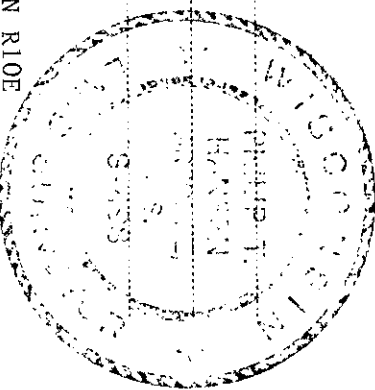

○ = Corner monument restored.

History of original corner establishment:

Original corner established by D.H. Vaughan, County Surveyor, in 1906 from which birch 10" bears N42°W, 9-1/2 links and birch 10" bears S43°E, 32 links. Corner re-established by H.C. Lawrence, Registered Land Surveyor, in 1946. He was unable to find the post or Vaughan's birch BT and no evidence that white or yellow birch had ever grown there. He did find a down spruce, fire scarred, on which there were scribble marks, lying about 20 links from post location. Set post at 18-1/2 links south of ^{random line} 18.43 equidistant between Section and Quarter Corner. Established NBT's: Spruce pine 9" S30°E, 40-1/2 links and spruce pine 9" N73°W, 32 links.

Description of corner evidence found:

Recovered Lawrence's 4" cedar post, squared and scribed S3 E-1/16 S10. Post had rotted off at ground level.
 Recovered OBT's: Spruce pine 9" (10") (jack) S30°E 40.5 links-scribed S10 E-1/16 NBT
 Spruce pine 9" (10") (jack) N73°W 32 links-scribed E-1/16 NBT

Description of monument and accessories I established to perpetuate the original location of this corner.

Replaced point of old post with 1-1/2" OD iron pipe w/2" brass cap stamped - S498 T36N R10E

No new accessories established.

E-1/16 $\frac{S|3}{S|10}$

CPI-1975

Dated at Rhineland, Wis., this 9th day of September, 1975.

Signature *Philip T. Hansen* Title Registered Land Surveyor Registration No. S-498
 (County Surveyor, Registered Land Surveyor, or other duly authorized official)

Office of Register of Deeds, County of Oneida
 Instrument was filed in this office for record on the 17th day of November 1975
 at 10:00 o'clock A.M.

Debra W. Berger
 (Register of Deeds)

By: Deputy

3610030010