

CERTIFIED LAND CORNER RESTORATION



Index No. **C-17**

State of Wisconsin

County of Oneida } ss.

I Phillip T. Hansen, do hereby certify that on the 14th day of August, 1975, I found evidence of the Quarter corner of Sections 2 and 3 Township 36, North, Range 10 East, Fourth Principal Meridian, as described hereon; and that from this evidence I established a new monument and accessories as described hereon to perpetuate the original location of this corner.

Resident witnesses:

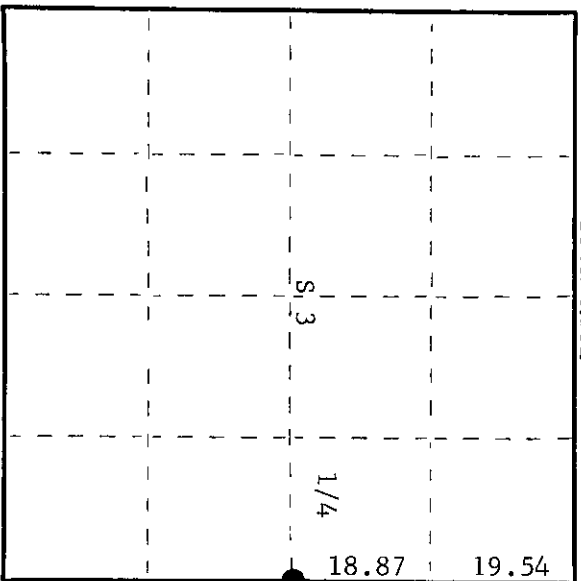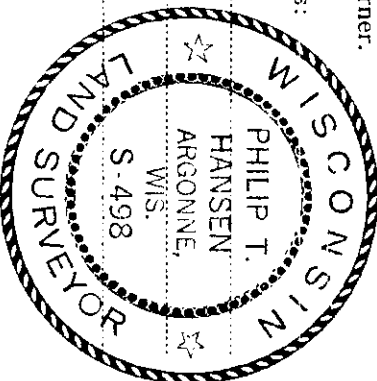

○ = Corner monument restored.

History of original corner establishment:

Original corner established by Wm. E. Dougherty, Government Deputy Surveyor, in 1863 from which yellow pine 10" bears N36°W, 40 links and yellow pine 10" bears S63°E, 48 links. Corner was restored by B.F. Dorr, County Surveyor, in 1897. Corner restored by H.C. Lawrence, Registered Land Surveyor, in 1950. He ran a random line south from Sections 34, 35, 2, and 3, a distance of 76.15 chains to a point 1.78 chains west of Section Corner 2, 3, 10, and 11. He was unable to recover Dorr's 1/4 post but set a new post at 38.41 chains south and east 90 links.

Description of corner evidence found:

Recovered Lawrence's 3" cedar post, squared and scribed 1/4S S2, 1/4S S3 in poor condition. Also recovered an old cedar point buried in the muck. No BT's were recovered.

Description of monument and accessories I established to perpetuate the original location of this corner.

Replaced wooden post with 2-1/2" iron pipe w/brass cap stamped -

NBT's: White birch 10" N16°W 65.8 links-scribed 1/4 BT  
Aspen 9" N62°W 32 links-scribed 1/4 BT

S498  
T36N R10E  
1/4 S3|S2  
CPT-1975

Dated at Rhineland, Wis., this 9th day of September, 1975.

Signature Phillip T. Hansen Title Registered Land Surveyor Registration No. S-498  
(County Surveyor, Registered Land Surveyor, or other duly authorized official)

Office of Registrar of Deeds, County of Oneida  
at 2:00 o'clock P on this office for record on the 14th day of October, 1975.  
I hereby certify that the within

Doris Verage Kuster  
(Registrar of Deeds)

By \_\_\_\_\_ Deputy

3610032000