

CERTIFIED LAND CORNER RESTORATION

Index No. **D-13**



State of Wisconsin

County of Oneida } ss.

I Philip T. Hansen, do hereby certify that on the 19 day of S-1/16, 1975, I found evidence of the S-1/16 corner of Sections 3 and 4 Township 36N North, Range 10 East, Fourth Principal Meridian, as described hereon; and that from this evidence I established a new monument and accessories as described hereon to perpetuate the original location of this corner.

Resident witnesses:

Glen Barker
Jim Clarlin

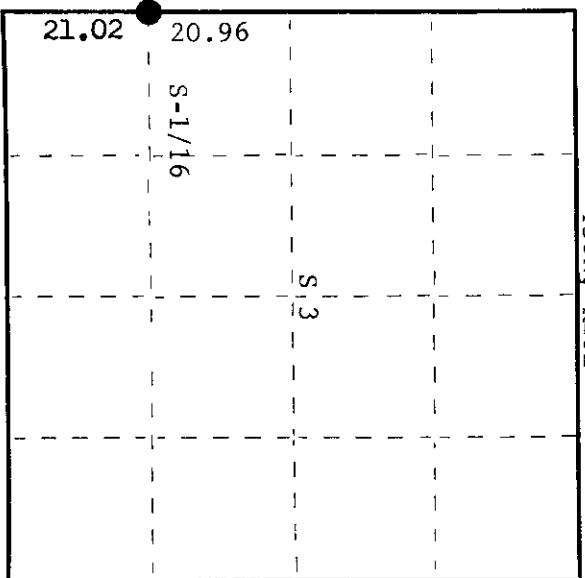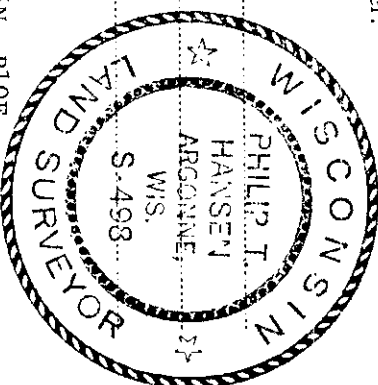

○ = Corner monument restored.

CERTIFIED LAND CORNER RESTORATION

History of original corner establishment:
Original corner established by D.H. Vaughan, County Surveyor, in 1906. Set post from which tamarack 14" bears N31° E, 20½ links and cedar 6" bears S52°W, 16 links.
Corner recovered by H.C. Lawrence, Registered Land Surveyor, in 1947. He recovered Vaughan's post, found both BT's down but scribe marks still visible. Set new 5" cedar post and made new BT's - dead tamarack stub 18", N25°E, 79 links, 50' high; white pine stub 16", S45°E, 89 links, about 20' high. These set on low ridge between swamps.

Description of corner evidence found:
Recovered H.C. Lawrence's 4" cedar post, squared and scribed S-1/16 S3, S-1/16 S4, in fair condition.
Recovered tamarack stub 18", 50' high, N25°E, 79 links, scribed 1/16 BT, fallen down.
Recovered white pine stub 16", 20' high, S45°E, 89 links, fallen down and decayed.

Description of monument and accessories I established to perpetuate the original location of this corner.
Replaced 4" cedar post with 1½" OD iron pipe with 2" brass cap stamped -

NBT's - Black spruce 8" N29°W 18 links scribed 1/16 BT S498
Black spruce 6" N24°W 40 links scribed 1/16 BT T36N, R10E

S-1/16 S4+S3
CPI-1975

Dated at Rhineland, Wis. this 18th day of August, 1975

Signature Philip T. Hansen Title Registered Land Surveyor Registration No. S-498
(County Surveyor, Registered Land Surveyor, or other duly authorized official)

Office of Register of Deeds, County of Oneida
Instrument was filed in this office for record on the 14th day of October, 1975
at 2:00 o'clock P. M.

Dennis George Kuehn
Register of Deeds

By Dennis George Kuehn Deputy

3610091000