
U.S. PUBLIC LAND SURVEY MONUMENT RECORD

Note: This form is intended and designed to fulfill all requirements of Wisconsin Administrative Code, Chapter A-E 5.02, U.S. Public Land Survey Monument Record (3) (a) (b) (c) (d) (e) (f) (g) (h) (i). An additional sheet may be added if necessary to conform with said requirements.

(a) Corner location: Township 36 North

Range 10 East/~~West~~

MEANDER CORNER
Left bank of
Pelican River

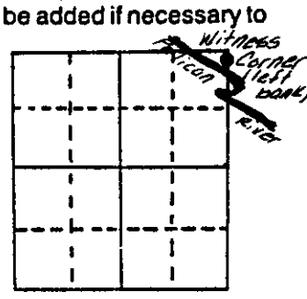

Section 6


Town/~~City/Village~~ Pelican

County Oneida

(b) (f) (g) (h) Description of monument found at this corner and if it was accepted, state all evidence (material, testimonial, occupational, plats, records, other monuments) used as a basis for accepting. If not accepted or if nothing was found, state evidence used as basis for establishing location. If reestablished through lost corner proportionate methods, indicate all monuments, distances and directions used to establish.

August 1863 - Willian E. Daugherty - Deputy Surveyor - Left bank Pelican River Set M.C. post. Original BT's: Tamarac N17½W, 15 links; Tamarac 9" N62°E, 32 links.
January 1931 - Harry C. Hall - County Surveyor - Found Original MC - on left bank
February 6, 1950 - Genisot Engineering Co. Map No 734-A - Identifies MC corner as being monumented with iron pipe.
March 1988 - James D. Rein, RLS - Found 1½" dia iron pipe below ice in river ± 6 feet from left bank. Set witness corner to the meander corner, a capped 2" dia x 60" long piston type aluminum monument. Made bearing trees to witness corner with aluminum nails in center of root crowns on side of tree facing corner. Set plastic stake 1½ feet Southwest of witness corner.

(c) (d) (e) Plan view of corner with ties to at least 4 witness monuments. If in disagreement with previously established corner, show the distances between the two corners and also indicate the ties to the disputed corner.

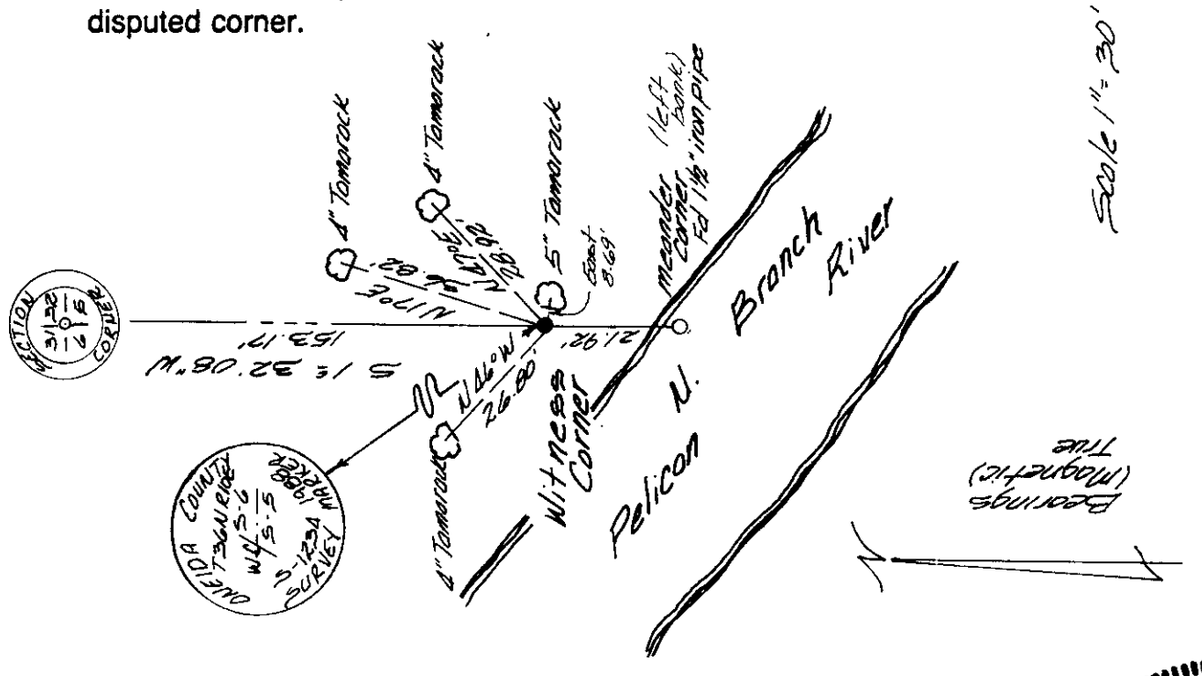

(i) I, James D. Rein, Registered Land Surveyor No. s-1234 (type or print name) certify that the corner location on this record was determined by me or under my direction and control and that this U.S. Public Land Survey Monument Record is correct and complete to the best of my knowledge and belief.

James D Rein — April 9th, 1988

Signature — Date

WISCONSIN JAMES D. REIN S-1234 MINOCQUA, WIS. LAND SURVEYOR

Index No. A-B-5 (Left Bank)

3610063900