

CERTIFIED LAND CORNER RESTORATION

Index No. **M-23**

State of Wisconsin

County of **Oneida** } ss.



I **Phillip T. Hansen**, do hereby certify that on the **14th** day of **December**, 19**76**, I found evidence of the **SC 1/16** corner of **Section 13** Township **36** North, Range **10 East**, Fourth Principal Meridian, as described hereon; and that from this evidence I established a new monument and accessories as described hereon to perpetuate the original location of this corner.

Resident witnesses:

Glen Barker

Jim Clarlin

Herb Wagoner

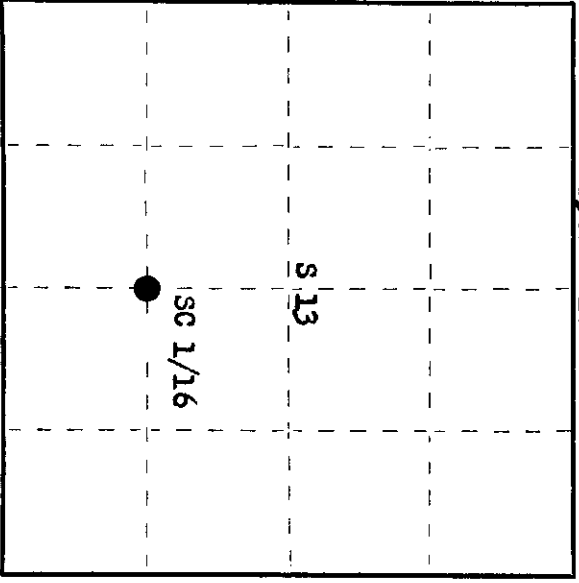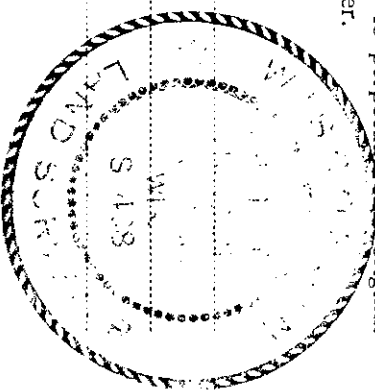

○ = Corner monument restored.

History of original corner establishment:

Corner established by D.H. Vaughan, County Surveyor, in 1900 and 1911. Set post and marked BTs - Cedar 10" N 71° W 9 links and Cedar 6" S 19° E 22 links. Corner recovered by H.C. Lawrence, Registered Land Surveyor, in 1951.

Description of corner evidence found:

Recovered Vaughan's old 3" squared cedar post lying down, scribing no longer visible.

Recovered Vaughan's BTs - Cedar 10" (16") N 71° W (N 74° W) 9 links, scribing partly visible. Cedar 6" (10") S 19° E (S 22° E) 22 links, scribing rotted out. Cedar 12" N 1° E 22.7 links, scribed 1/8S BT. Origin unknown.

Used cross ties to BTs to determine location of old post.

Description of monument and accessories I established to perpetuate the original location of this corner.

Set 1 1/2" OD iron pipe with 2" brass cap in old location, cap stamped: Monument projects 2 1/2" above ground.

NBT - Cedar 7" N 32° W 43 links, scribed 1/16 BT.

34.98
T36N R10E
SC 1/16 S 13
CPI-1976

Dated at **Rhineland**, Wis., this **19th** day of **January**, 19**77**.

Signature **Phillip T. Hansen** Title **Registered Land Surveyor** Registration No. **S-498**
(County Surveyor, Registered Land Surveyor, or other duly authorized official)

Office of Register of Deeds, County of **Oneida**, at **10** o'clock **P**. M. on the **24th** day of **February**, 19**77**.
I hereby certify that the within instrument was filed in this office for record on the

Doris L. Terpen Kuehn
(Register of Deeds)

By: _____ Deputy

3610131020