

CERTIFIED LAND CORNER RESTORATION

Index No. **N-19**

State of Wisconsin

County of Oneida } ss.

I Phillip T. Hansen, do hereby

certify that on the 22nd day

of July, 1975, I found

evidence of the Quarter

corner of Sections 14 and 23

Township 36, North, Range


10 East, Fourth Principal Meridian,

as described hereon; and that from this evidence


I established a new monument and accessories

as described hereon to perpetuate the original

location of this corner.

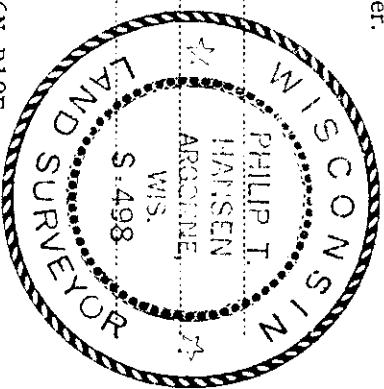

Resident witnesses:

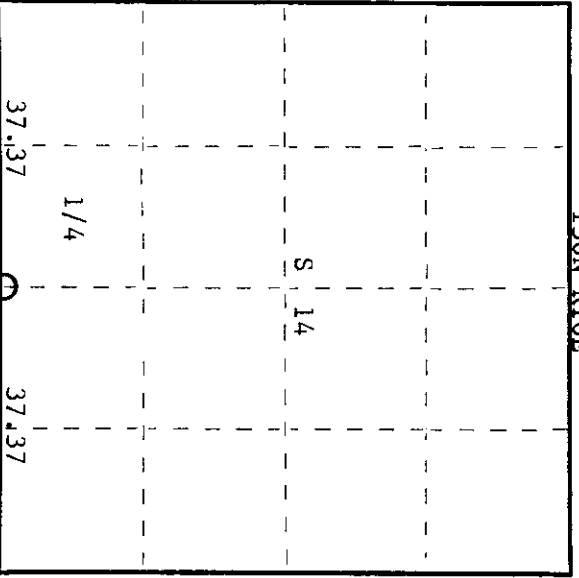

History of original corner establishment:

Original corner established by Wm. E. Dougherty, Government Deputy Surveyor, in 1859, from which birch 9" bears N6°W 10 links and birch 6" bears S35°E 8 links.

Corner recovered by D.H. Vaughan, County Surveyor, in 1900-11. Set new stake from which white pine stub 20" bears N76°W 17 links, hemlock 10" bears N43½°W.

Corner recovered by H.C. Lawrence, Registered Land Surveyor. Set new post in old road from which lind 14" bears S45°E 8½ links and oak 14" bears S45°W 21½ links.

Description of corner evidence found:


Recovered 5" cedar post, squared and scribed 1/4-S S14, 1/4-S S23 in poor condition.

Recovered OBT's - White pine stub 20" N76°W 17 links - now a decayed stump.

Lind (basswood) S45°E 8.5 links - now a 7' stub, scribing rotted out.
R. oak 14" (16") S45°W (S50°W) 21.5 links - scribing grown over.

Description of monument and accessories I established to perpetuate the original location of this corner.
Replaced 5" cedar post with 2½" iron pipe with brass cap stamped -

NBT's - Sugar 10" N88°E 11 links - scribed 1/4 BT.
White birch 9" N56°W 26 links - scribed 1/4 BT.

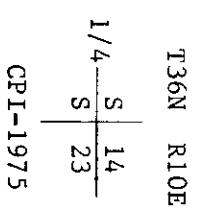

Dated at Rhineland, Wis., this 31st day of July, 1975.

Signature Phillip T. Hansen Title Registered Land Surveyor Registration No. S-498
(County Surveyor, Registered Land Surveyor, or other duly authorized official)

Office of Register of Deeds, County of Oneida
Instrument was filed in this office for record on the 1st day of October, 1975
at 3:00 o'clock P.M.

Doris Vergge Ruelm
(Register of Deeds)

By: _____ Deputy

3610140020