

CERTIFIED LAND CORNER RESTORATION

Index No. N-15

State of Wisconsin }
 County of Oneida } ss.



I Philip T. Hansen, do hereby certify that on the 19th day of May, 1976, I found evidence of the quarter corner of section 15 and 22 Township 36, North, Range 10 East, Fourth Principal Meridian, as described hereon; and that from this evidence I established a new monument and accessories as described hereon to perpetuate the original location of this corner.

Resident witnesses.

Glen Barker

Jim Clafin

Herb Wagoner

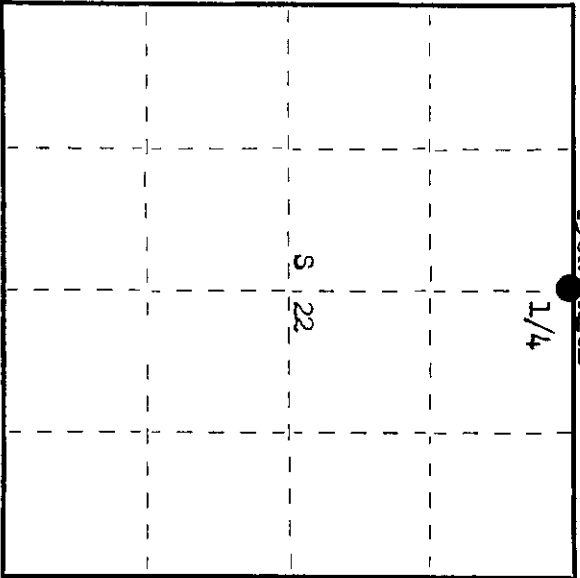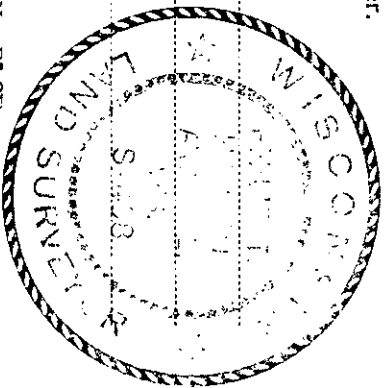

○ = Corner monument restored.

History of original corner establishment: Original Corner established by Wm. D. Dougherty, Deputy Surveyor, in 1863, from which Birch 8" bears S 16° E 49 lks and Birch 12" bears N 13° W 53 lks.
 Corner restored in 1900 by D.H. Vaughan, County Surveyor, marked w/BTs - Tamarack 8" N 45 1/2° W, 7 1/2 lks, Tamarack 12" S 12° E 29 lks.
 Corner recovered by H.C. Lawrence, registered Land Surveyor, in 1947, recovered Vaughan's old post and tamarack BT 8" N 45° W 7 1/2 lks. Also an iron pipe, set new post.

Description of corner evidence found:

Recovered 5" tamarack post, squared and scribed 1/4" S15, 1/4" S22, in very poor condition. Also recovered a 2 1/2" iron pipe with brass cap, scribed 1/4" Sec. 15-22. Position of Lawrence's post fits ties to tamarack 8" N 45° W 7.5 lks. Recovered OBT - Tamarack 8" N 45° W 7.5 lks, now a 3" stub, scribed 1/4".

Description of monument and accessories I established to perpetuate the original location of this corner. Extracted the post and iron pipe from the muck and reset iron pipe in post hole. Drove support stakes beside it to sturdy pipe. Added stamping to cap, now stamped.

NBTs - Black Spruce 5" S 4° E 45.9 lks, scribed 1/4" BT. Tamarack 8" S 24° W 73.3 lks, scribed 1/4" BT.
 Monument sets in a wet tag alder swamp. No other suitable trees for BTs.
 Monument and BTs painted blue.

Dated at Oneida, Wis., this 4th day of August, 1976.
 Signature Philip T. Hansen Title Registered Land Surveyor Registration No. 5498
 (County Surveyor, Registered Land Surveyor, or other duly authorized official)

Office of Register of Deeds, County of Oneida.
 Instrument was filed in this office for record on the 22nd day of September, 1976, at 100 o'clock M.
 I hereby certify that the within

Dorcas Verage Kuehn
 (Register of Deeds)

By: _____ Deputy

3610150020