

CERTIFIED LAND CORNER RESTORATION

Index No. P2

State of Wisconsin

County of Oneida } ss.



I Phillip T. Hansen, do hereby certify that on the 21st day of August, 19 79, I ~~found~~ established the WC 1/16 corner of Section 19 Township 36, North, Range 10 East, Fourth Principal Meridian, as described hereon; and that from this evidence I established a new monument and accessories as described hereon to perpetuate the original location of this corner.

Resident witnesses:

Glen Barker

Jim Claflin

Herb Wagoner

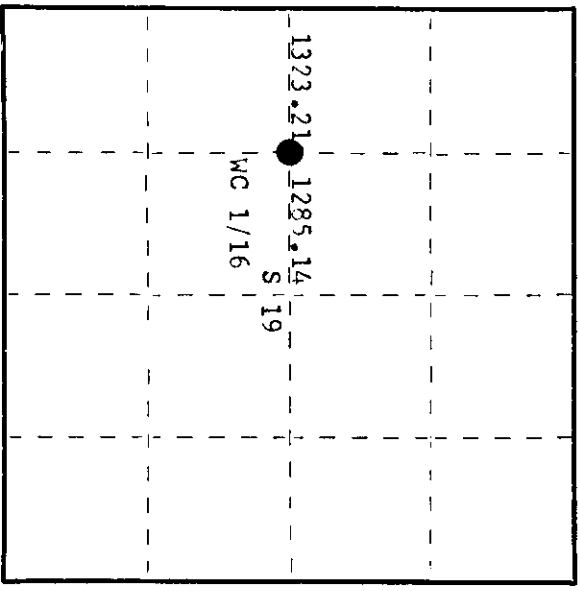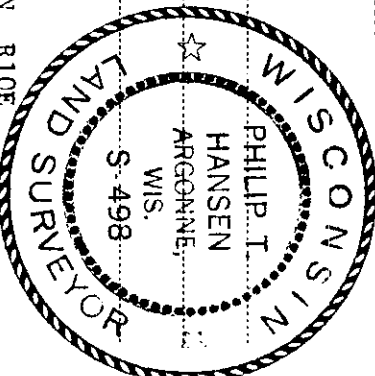

○ = Corner monument restored.

History of original corner establishment:

No record of any previous survey.

Description of corner evidence found:

No evidence of any corner recovered. Corner established by traverse and computation. Computed distance from 1/4 corner between Sections 19 and 24 to C 1/4 corner Section 19 is 2608.261 feet at bearing N 79° 16' 55" E. Set WC 1/16 at proportional distance 1323.121 feet N 79° 16' 55" E of 1/4 corner and 1285.14 S 79° 16' 55" W of C 1/4.

Description of monument and accessories I established to perpetuate the original location of this corner. Set a 1-1/2" iron pipe with 2" brass cap, projecting 24", stamped:

- Marked NBT's -
- Tamarack 8" S58°E 6.4 feet S498
- Tamarack 9" N89°W 6.90 feet T36N R10E
- both scribed 1/16 BT WC 1/16 S 19
- CPI-1979

Dated at Rhineland, Wis., this 27th day of August, 19 79

Signature Phillip T. Hansen Title Registered Land Surveyor Registration No. S-498
(County Surveyor, Registered Land Surveyor, or other duly authorized official)

Office of Register of Deeds, County of Oneida, I hereby certify that the within instrument was filed in this office for record on the 17th day of September, 19 79 at 105 o'clock M.

Doris Urzaga Tucker
(Register Deeds)

By: _____ Deputy

3610 19 2030