

CERTIFIED LAND CORNER RESTORATION



Index No. P-6

State of Wisconsin

County of Oneida } ss.

I, Phillip T. Hansen, do hereby certify that on the 3rd day of March, 1979, I found ~~established~~ the MC 1/16 corner of Section 20, Township 36, North, Range 10 East, Fourth Principal Meridian, as described hereon; and that from this evidence I established a new monument and accessories as described hereon to perpetuate the original location of this corner.

Resident witnesses:  
Glen Barker  
Jim Clafflin  
Herb Wagoner

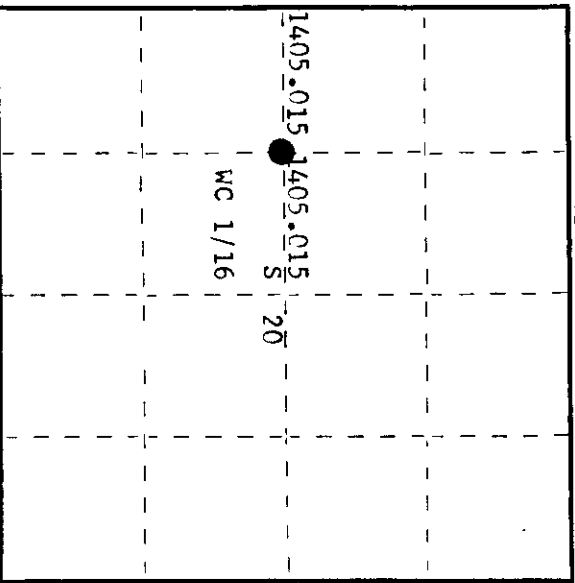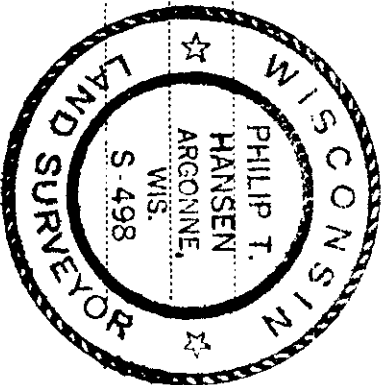

○ = Corner monument restored.

History of original corner establishment:

No records of any previous survey.

Description of corner evidence found:

No evidence of any corner recovered. Corner established by traverse and computation. C 1/4 corner established at point S 89° 14' 33" E 2810.03' from W 1/4 corner. WC 1/16 established at 1405.015' intermediate.

Description of monument and accessories I established to perpetuate the original location of this corner.

Set 1-1/2" iron pipe with 2" brass cap, stamped: S498  
Monument projects 18" above ground. T36N R10E  
Marked NBT's - Twin Maple 6" S14°E 14.6 feet, scribed 1/16 BT WC 1/16 S 20  
Twin Maple 6" N80°E 38.63 feet, scribed 1/16 BT CPT-1979

Dated at Rhinelander, Wis, this 8th day of May, 1979

Signature: Phillip T. Hansen Title: Registered Land Surveyor Registration No. S-498  
(County Surveyor, Registered Land Surveyor, or other duly authorized official)

Office of Register of Deeds, County of Oneida I hereby certify that the within instrument was filed in this office for record on the 14th day of May, 1979 at 30 o'clock M.

Donna Savage Kuehn  
(Register of Deeds)

By: \_\_\_\_\_ Deputy

3610202030