

CERTIFIED LAND CORNER RESTORATION



Index No. R-15

State of Wisconsin }  
 County of Oneida } ss.

I Philip T. Hansen, do hereby certify that on the 19th day of May, 1976, I found evidence of the quarter corner of Section 22 and 27 Township 36 North, Range 10 East, Fourth Principal Meridian, as described hereon; and that from this evidence I established a new monument and accessories as described hereon to perpetuate the original location of this corner.

Resident witnesses:

Glen Barker  
 Jim Claflin  
 Herb Wagoner

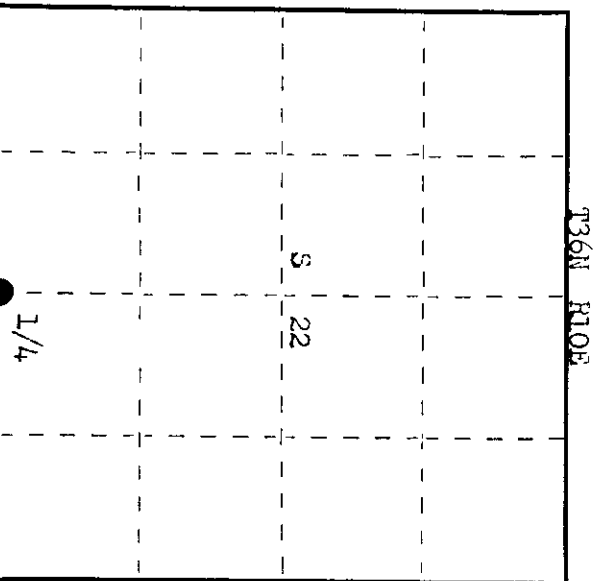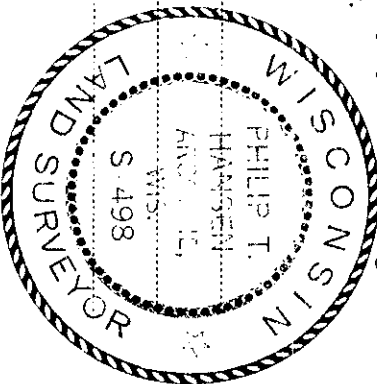

○ = Corner monument restored.

History of original corner establishment: Original Corner established by Wm. W. Dougherty, Deputy Surveyor, in 1863, from which fir 8" bears S 37° W 23 lks and Birch 8" bears N 56° W 14 lks. Corner recovered in 1910 by D.H. Vaughan, County Surveyor, recovered original BTs.

Corner recovered by H.C. Lawrence, Registered Land Surveyor, in 1947. Found Vaughan's old post. Set new post and marked NBT - Spruce 16" S 5° W 62½ lks, telephone pole 1401 is 2 chains north.

Description of corner evidence found:

Recovered 4" squared cedar post, scribed 22 1/4 S 27 with large rock cairn built up around base. Post was in poor condition.

Recovered NBT - Spruce 16" S 5° W 62.5 lks, scribed 1/4 S 27 BT, now a 10' stub.

The telephone line has been removed.

Description of monument and accessories I established to perpetuate the original location of this corner.

Replaced cedar post with 2½" aluminum pipe with cap (Bernitsen #1 Federal Monument), projecting 24" above ground. Cap stamped.

Replaced rock cairn around base of monument.

NBT - Black Spruce 10" N 20° W 119.3 lks, scribed 1/4 BT.

" Spruce 6" N 18° W 119 lks, scribed 1/4 BT.

Corner sets on the north edge of wet tag alder swamp.

Monument and BTs painted blue.

3498  
 T36N R10E  
 S 22  
 1/4 S 27  
 1976

Dated at Rhinelander, Wis., this 4th day of August, 1976.

Signature Philip T. Hansen Title Registered Land Surveyor Registration No. 3498  
 County Surveyor, Registered Land Surveyor, or other duly authorized official

Office of Register of Deeds, County of Oneida. I hereby certify that the within instrument was filed in this office for record on the 22nd day of September, 1976, at 1:00 o'clock P.M.

Doris Savage Kuehn  
 (Register of Deeds)

By: Deputy

3610 220020