

State of Wisconsin
County of **Oneida** } ss.

I, **Philip F. Hansen**, do hereby
certify that on the **4th** day
of **January**, 19**77**, I found
evidence of the **Section Corner**
corner of **23, 24, 25, 26**
Township **36**, North, Range
10 East, Fourth Principal Meridian,
as described hereon; and that from this evidence


I established a new monument and accessories
as described hereon to perpetuate the original
location of this corner.

Resident witnesses:

Glen Barker

Jim Clarlin

Herb Wagoner

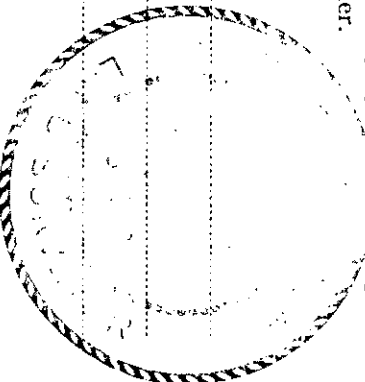

T36N R10E

S 24

SC

○ = Corner monument restored.

History of original corner establishment: Original Corner established by **Wm. E. Dougherty**, Deputy Surveyor, in 1863, from which Tamarack 12" bears N 79° W 6 links and Tamarack 10" bears N 35° E 7 links.

This corner recovered by **D.H. Vaughan**, County Surveyor, set new post and marked **NBT - Tamarack 12" N 29° W 54 links**.

H.C. Lawrence, Registered Land Surveyor, restored Corner in 1947. He found an iron pipe and old cedar post along side. He also found **Vaughan's Tamarack BT**, a high stump, all marks intact. He disregarded the iron pipe and reset his Corner from **Vaughan's OBT** from which he recovered **Vaughan's old point**. Marked **NBTs - White Pine 24" N 36° W 88 links**, **White Pine 20" S 66° E 84 1/2 links**.

Description of corner evidence found:

Recovered Lawrence's 5" cedar post, squared and scribed S23, S24, S25, S26 in poor condition. Also recovered the iron pipe 2 1/2" with brass cap, stamped wrong. This bore N 43° W 33 links from Lawrence's post.

Recovered OBT - Vaughan's tamarack 12" N 32° W 54.5 links, now a decayed stump. Lawrence's White Pine 24" (26") N 36° W 88 links, scribed S23 T36N R10E. White Pine 20" (24") S 66° E 84.5 links, scribed S25 NBT.

Description of monument and accessories I established to perpetuate the original location of this corner.

Replaced cedar post with 2 1/2" Berritsen A-1 Federal Monument, aluminum with magnet installed in cap and base. Cap stamped:

T36N R10E

Sec. 23 | 24
26 | 25

Monument projects 24" above ground. NBT - Black Ash 12" N 54° W 12 links, scribed SC BT. Black Ash 6" N 19° E 23 links, scribed SC BT. Removed old iron pipe from its location and laid it beside new one.

54.98-1977

Dated at **Rhineland**, Wis., this **20th** day of **January**, 19**77**.

Signature **Philip F. Hansen** Title **Registered Land Surveyor** Registration No. **5498**
(County Surveyor, Registered Land Surveyor, or other duly authorized official)

Office of Register of Deeds, County of **Oneida**
I hereby certify that the within
instrument was filed in this office for record on the **24th** day of **February**, 19**77**
at **1:00** o'clock **P.**M.

Signature **Dorcas Verage Kuehn**
(Register of Deeds)

By: Deputy