

CERTIFIED LAND CORNER RESTORATION

Index No. **P-20**

State of Wisconsin

County of Oneida } ss.

I Phillip T. Hansen, do hereby certify that on the 5th day of January, 1977, I found evidence of the EC 1/16 corner of Section 23 Township 36, North, Range 10 East, Fourth Principal Meridian,


as described hereon; and that from this evidence I established a new monument and accessories as described hereon to perpetuate the original location of this corner.

Resident witnesses:


Glen Barker

Jim Craftin

Herb Wagoner

 

T36N R10E

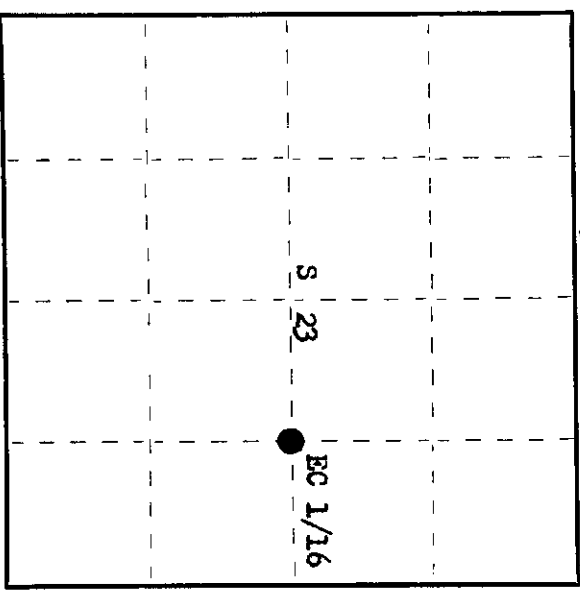

○ = Corner monument restored.

History of original corner establishment:

Corner established by D.H. Vaughan, County Surveyor, in 1910. Set Birch 11" N 60 1/2° E 18 1/2 links and White Pine 1 1/4" N 89 1/2° W 27 1/2 links. Corner recovered by H.C. Lawrence, Registered Land Surveyor, in 1948. Found Vaughan's old BFs and set new post from them and marked NBTs - Oak 1 1/4" N 50° E 7 1/2 links and Maple 1 1/4" S 10° W 14 1/2 links.

Description of corner evidence found:

Recovered Lawrence's 6" cedar post, squared and scribed EC 1/16 S23, EC 1/16 S23, with rock cairn around it. Post was in poor condition. Recovered OBT - Vaughan's White Pine 1 1/4" N 89° 30' W, 27.5 links, now a decayed stump. Lawrence's Maple 1 1/4" S 10° W 14.5 links, now a cut off stump. Oak 1 1/4" (18") N 50° E 7.5 links, scribing grown over.

Description of monument and accessories I established to perpetuate the original location of this corner.

Replaced 6" cedar post with 1 1/2" OD iron pipe with 2" brass cap, stamped: Monument projects 24" above ground. NBT - Maple 6" S 22° W 15.9 links, scribed 1/16 BF.

S498
T36N R10E
EC 1/16 S 1/23
CPI-1977

Dated at Rhinelander, Wis., this 20th day of January, 1977.

Signature Phillip T. Hansen Title Registered Land Surveyor Registration No. S-498
(County Surveyor, Registered Land Surveyor, or other duly authorized official)

Office of Registrar of Deeds, County of Oneida. I hereby certify that the within instrument was filed in this office for record on the 24th day of February, 1977 at 10 o'clock P. M.

Doree Verage Fischer
(Registrar of Deeds)

By: _____ Deputy

3610232010