

CERTIFIED LAND CORNER RESTORATION



Index No. **Q-23**

State of Wisconsin }
County of Oneida } ss.

I Philip T. Hansen, do hereby
certify that on the 28th day
of December 19 76, I found
evidence of the SC 1/16
corner of Section 24
Township 36, North, Range
10 East, Fourth Principal Meridian,

as described hereon; and that from this evidence
I established a new monument and accessories
as described hereon to perpetuate the original
location of this corner.

Resident witnesses
Glenn Barker
Jim Clafin
Herb Wagoner

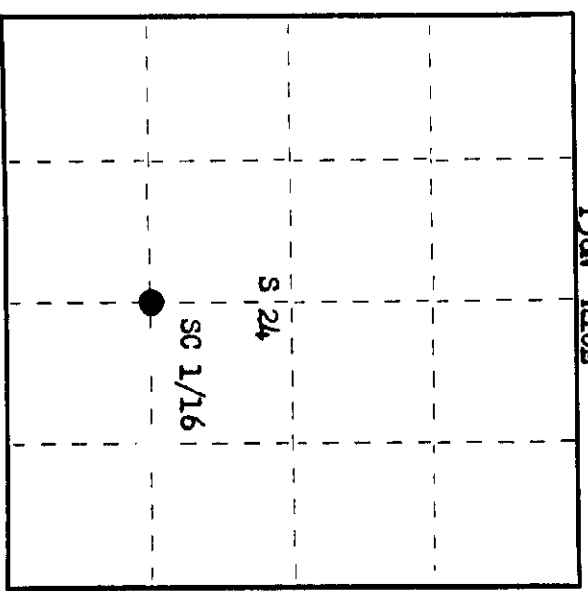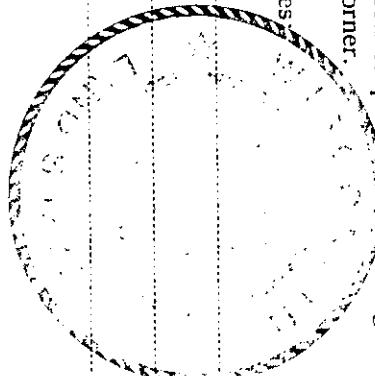

○ = Corner monument restored.

History of original corner establishment:

Original corner established by D.H. Vaughan, County Surveyor, in 1910. Set post and marked BTs - Ash 12" N 45° W 20 1/2 links and Birch 15" N 79° E 28 1/2 links.

Corner recovered by H.C. Lawrence, Registered Land Surveyor, in 1947. Set new post from Vaughan's BTs.

Description of corner evidence found:

Recovered Lawrence's 5" cedar post, squared and scribed SC 1/16 S24, SC 1/16 in poor condition.

Recovered Vaughan's old BT - Birch 15" N 79° E 28.5 links, scribed 1/8 BT, now 20' stub. Cedar 10" N 16° E 24.5 links, scribed SC 1/16 NBT believed to be Lawrence's BT. This is laying down, blazes still intact.

Description of monument and accessories I established to perpetuate the original location of this corner.

Replaced 5" cedar post with 1 1/2" iron pipe with 2" brass cap, stamped: S498
Monument projects 18" above ground. T36N R10E
NBTs - Cedar 6" S 39° E 48.4 links, scribed 1/16 BT. SC 1/16 S 24
Cedar 7" S 53° W 49.3 links, scribed 1/16 BT. CPI-1976
Propped old post beside new monument.

Dated at Rhineland, Wis., this 19th day of January, 1977.

Signature Philip T. Hansen Title Registered Land Surveyor Registration No. S-498
(County Surveyor, Registered Land Surveyor, or other duly authorized official)

Office of Register of Deeds, County of Oneida 5th day of May, 1977
at 2:00 o'clock P. M. I hereby certify that the within

Dennis George Kuehn
(Register of Deeds)

By _____ Deputy

3610241020