

CERTIFIED LAND CORNER RESTORATION


Index No. PC 112

State of Wisconsin }
County of Oneida } ss.

I Phillip T. Hansen do hereby certify that on the 10th day of December 19 76, I found evidence of the M.C. - NW Cor., Gov., Lot 4 corner of Section 19 Township 36 North, Range 11 East, Fourth Principal Meridian,

as described hereon; and that from this evidence I established a new monument and accessories as described hereon to perpetuate the original location of this corner.

Resident witnesses:
Glen Barker
Jim Claffin
Herb Wagoner

 

History of original corner establishment:

Original corner established by Hiram C. Fellows in 1859 from which Cedar 8" bears S 30° W 10 links and Cedar 8" bears S 77° W 18 links.
Corner re-established by D.H. Vaughan, County Surveyor, in 1900.
Corner recovered by H.C. Lawrence, Registered Land Surveyor. Set new post. No mention made of BTs established.


Description of corner evidence found:

Recovered old point of Vaughan's original corner intact in mud. Recovered Lawrence's 3" cedar post, squared and scribed S19, MC Sec. 24.
Also recovered a 2 1/2" iron pipe with brass cap (not stamped) setting beside it.
Recovered OBT - Cedar 10" stub 5' high due east 6.5 links, scribed T36N R11E S19.

Description of monument and accessories I established to perpetuate the original location of this corner.

Replaced Lawrence's post with 2 1/2" iron pipe with brass cap set in hole of old point set by Vaughan. Cap stamped:
Monument projects 2' above ground.
Corner sets 1.5 chains south of Bug Lake (Neptune Lake).
NBTs - Cedar 6" N 36° W 59 links
Black Ash 10" N 89° W 68 links, both scribed M.C. BT.

S498
T36N R
10 M.C. 24 19 11 E
Gov. Lot 4
CPI - 1976

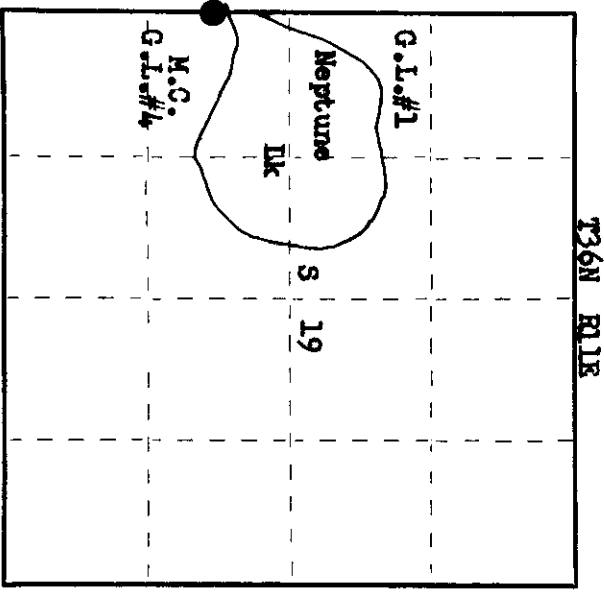

○ = Corner monument restored.

Dated at Rhinelander, Wis., this 15th day of December, 1976.
Signature Phillip T. Hansen Title Registered Land Surveyor Registration No. S-498
(County Surveyor, Registered Land Surveyor, or other duly authorized official)
Office of Register of Deeds, County of Oneida.
Instrument was filed in this office for record on the 7th day of February, 1977 at 1:45 o'clock P. M.
I hereby certify that the within
Doris Savage Tucker
(Register of Deeds)
By Joseph M. Brown Deputy

00941600